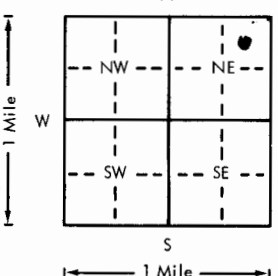
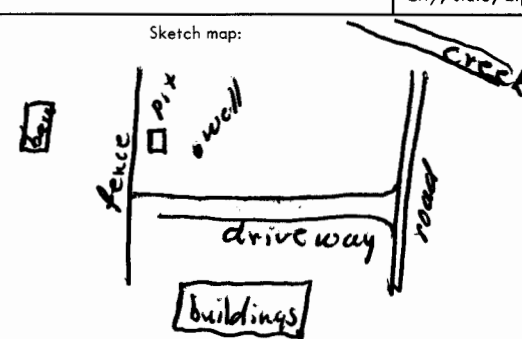


USE TYPEWRITER OR BALL
POINT PEN-PRESS FIRMLY,
PRINT CLEARLY.

WATER WELL RECORD
KSA 82a-1201-1215

Kansas Department of Health and
Environment-Division of Environment
(Water well Contractors)
Topeka, Kansas 66620

1. Location of well:		County Gray	Fraction NE 1/4 NE 1/4 NE 1/4	Section number 36	Township number T 29 S	Range number R 29 E	
2. Distance and direction from nearest town or city: 1/2 E 75 of Montezuma, KS Street address of well location if in city:			3. Owner of well: Otis Elliot R.R. or street: City, state, zip code: Montezuma Kansas				
4. Locate with "X" in section below: 		Sketch map: 		6. Bore hole dia. 8 1/2 in. Completion date 12-21-78 Well depth 120 ft.			
5. Type and color of material		From		To		7. <input type="checkbox"/> Cable tool <input checked="" type="checkbox"/> Rotary <input type="checkbox"/> Driven <input type="checkbox"/> Dug <input type="checkbox"/> Hollow rod <input type="checkbox"/> Jetted <input type="checkbox"/> Bored <input type="checkbox"/> Reverse rotary	
						8. Use: <input type="checkbox"/> Domestic <input type="checkbox"/> Public supply <input type="checkbox"/> Industry <input type="checkbox"/> Irrigation <input type="checkbox"/> Air conditioning <input checked="" type="checkbox"/> Stock <input type="checkbox"/> Lawn <input type="checkbox"/> Oil field water <input type="checkbox"/> Other	
						9. Casing: Material <input type="checkbox"/> Height: Above or below Threaded <input type="checkbox"/> Welded <input type="checkbox"/> Surface 12 in. RMP <input type="checkbox"/> PVC <input checked="" type="checkbox"/> Weight 200 lbs./ft. Dia. 5 in. to 120 ft. depth <input checked="" type="checkbox"/> Thickness: inches or Dia. <input type="checkbox"/> in. to <input type="checkbox"/> ft. depth gage No. 10 inch	
						10. Screen: Manufacturer's name Jet Stream Type PVC Dia. 5" Slot/gauze 46" Length 20' Set between 100 ft. and 120 ft. <input type="checkbox"/> ft. and <input type="checkbox"/> ft. Gravel pack? <input checked="" type="checkbox"/> Size range of material 4-12"	
						11. Static water level: <input type="checkbox"/> mo./day/yr. 40 ft. below land surface Date 12-21-78	
						12. Pumping level below land surfaces: 40 ft. after 1 1/2 hrs. pumping 30 g.p.m. <input type="checkbox"/> ft. after <input type="checkbox"/> hrs. pumping <input type="checkbox"/> g.p.m. Estimated maximum yield 30 g.p.m.	
						13. Water sample submitted: <input type="checkbox"/> mo./day/yr. <input type="checkbox"/> Yes <input checked="" type="checkbox"/> No Date <input type="checkbox"/>	
						14. Well head completion: <input checked="" type="checkbox"/> Pitless adapter 12 inches above grade	
						15. Well grouted? Yes With: <input type="checkbox"/> Neat cement <input type="checkbox"/> Bentonite <input checked="" type="checkbox"/> Concrete Depth: From 5 ft. to 15 ft.	
						16. Nearest source of possible contamination: ft. 800 Direction N Type Creek Well disinfected upon completion? <input type="checkbox"/> Yes <input type="checkbox"/> No	
						17. Pump: Manufacturer's name Flint & Walling Model number 5BA8 HP 5 Volts 230 Length of drop pipe 105 ft. capacity 12 g.p.m. Type: <input checked="" type="checkbox"/> Submersible <input type="checkbox"/> Turbine <input type="checkbox"/> Jet <input type="checkbox"/> Reciprocating <input type="checkbox"/> Centrifugal <input type="checkbox"/> Other	
						20. Water well contractor's certification: This well was drilled under my jurisdiction and this report is true to the best of my knowledge and belief. Bartel 101A Business name License No. Address Wadsworth Signed Robert Bartel Date 2-6-79 Authorized representative	
						18. Elevation:	
						19. Remarks:	
						Topography: <input type="checkbox"/> Hill <input type="checkbox"/> Slope <input checked="" type="checkbox"/> Upland <input type="checkbox"/> Valley	

Forward the white, blue and pink copies to the Department of Health and Environment

Form WWC-5