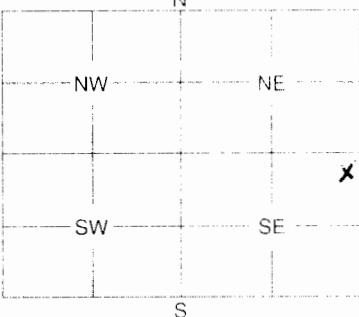


1	LOCATION OF WATER WELL County: <u>Gray</u>	Fraction <u>NE NE SE</u> <small>1/4 1/4 1/4</small>	Section Number <u>5</u>	Township Number <u>29</u>	Range Number <u>29</u> <small>EW</small>
Distance and direction from nearest town or city street address of well if located within city? <u>31505 9 Rd. Montezuma, KS 67867</u>					
2	WATER WELL OWNER: RR #, St. Address, Box #: <u>31505 9 Rd.</u> City, State, ZIP Code: <u>Montezuma, KS 67867</u>	Board of Agriculture, Division of Water Resources Application Number:			
3	MARK WELL'S LOCATION WITH AN "X" IN SECTION BOX: 	4	DEPTH OF WELL <u>180</u> ft.		
		5	WELL'S STATIC WATER LEVEL <u>174</u> ft.		
		WELL WAS USED AS:			
		<input checked="" type="checkbox"/> 1 Domestic <input type="checkbox"/> 2 Irrigation <input type="checkbox"/> 3 Feedlot <input type="checkbox"/> 4 Industrial		<input type="checkbox"/> 5 Public Water Supply <input type="checkbox"/> 6 Oil Field Water Supply <input type="checkbox"/> 7 Domestic (Lawn & Garden) <input type="checkbox"/> 8 Air Conditioning	
		<input type="checkbox"/> 9 Dewatering <input type="checkbox"/> 10 Monitoring Well <input type="checkbox"/> 11 Injection Well <input type="checkbox"/> 12 Other			
		Was a chemical / bacteriological sample submitted to Department? Yes No <input checked="" type="checkbox"/> If yes, mo/day/yr sample was submitted			
		Water Well Disinfected: Yes <input checked="" type="checkbox"/> No			
5	TYPE OF BLANK CASING USED:				
	1 Steel <input checked="" type="checkbox"/> PVC	3 RMP (SR) 4 ABS	5 Wrought 6 Asbestos-Cement	7 Fiberglass 8 Concrete Tile	9 Other (Specify below)
	Blank casing diameter <u>5</u> in.		Was casing pulled?	Yes No <input checked="" type="checkbox"/>	If yes, how much
	Casing height above or <u>below</u> land surface <u>30</u> in.				
6	GROUT PLUG MATERIAL:		1 Neat cement	2 Cement grout	<input checked="" type="checkbox"/> 3 Bentonite 4 Other
	Grout Plug Intervals:		From <u>0</u> ft.	to <u>20</u> ft.	From ft. to ft., From to ft.
	What is the nearest source of possible contamination:				
	1 Septic tank 2 Sewer lines 3 Watertight sewer lines 4 Lateral lines 5 Cess pool	6 Seepage pit 7 Pit privy 8 Sewage lagoon 9 Feedyard 10 Livestock pens	11 Fuel storage 12 Fertilizer storage 13 Insecticide storage 14 Abandoned water well 15 Oil well/Gas well	16 Other (specify below) <u>None observed</u>	
	Direction from well? How many feet?				
	FROM	TO	PLUGGING MATERIALS		
	<u>0</u>	<u>20</u>	<u>Bentonite chips</u>		
	<u>20</u>	<u>174</u>	<u>Compacted clays</u>		
	<u>174</u>	<u>180</u>	<u>chlorinated sand</u>		
7	CONTRACTOR'S OF LANDOWNER'S CERTIFICATION: This water well was plugged under my jurisdiction and was completed on (mo/day/year) <u>3/27/11</u> and this record is true to the best of my knowledge and belief. Kansas Water Well Contractor's License No. <u>5-231</u> This Water Well Record was completed on (mo/day/year) <u>11/12/11</u> under the business name of <u>Jantzen Water Well</u> by (signature) <u>[Signature]</u>				
INSTRUCTIONS: Use typewriter or ball point pen. Please press firmly and print clearly. Please fill in blanks, underline or circle the correct answers. Send top three copies to Kansas Department of Health and Environment, Bureau of Water, Geology Section, 1000 SW Jackson St., Ste. 420, Topeka, Kansas 66612-1367. Telephone: 785/296-5522. Send one to Water Well Owner and retain one for your records.					