

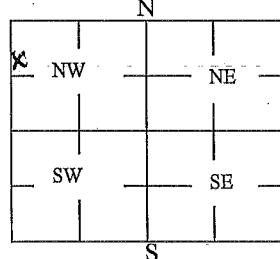
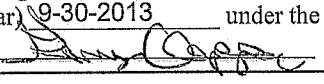
## WATER WELL PLUGGING RECORD

## Form WWC-5P

KSA 82a-1212

ID NO.

12035

1 LOCATION OF WATER WELL:		Fraction County: GRAY 1/4 1/4 1/4 NW 1/4	Section Number 7	Township Number T 29 S	Range Number 29 <input type="checkbox"/> E <input checked="" type="checkbox"/> W	
Street/Rural Address of Well Location; if unknown, distance & direction from nearest town or intersection: If at owner's address, check here <input type="checkbox"/> SE of Copeland Ks. from the intersection of Road GG & Road 7; 3/4 mile north on the east side			Global Positioning Systems (GPS) information: Latitude: 37.54363 N (in decimal degrees) Longitude: 100.54306 W (in decimal degrees) Elevation: Datum: <input type="checkbox"/> WGS84, <input type="checkbox"/> NAD83, <input checked="" type="checkbox"/> NAD27 Collection Method:	
2 WATER WELL OWNER: Gene Koehn RR#, St. Address, Box #: 6168 C Road City, State ZIP Code: Copeland Ks., 67837			<input checked="" type="checkbox"/> GPS unit (Make/Model): Magellan eXplorist GC <input type="checkbox"/> Digital Map/Photo, <input type="checkbox"/> Topographic Map, <input type="checkbox"/> Land Survey Est. Accuracy: <input type="checkbox"/> < 3 m, <input type="checkbox"/> 3-5 m, <input type="checkbox"/> 5-15 m, <input type="checkbox"/> > 15 m	
3 MARK WELL'S LOCATION WITH AN "X" IN SECTION BOX:		4 DEPTH OF WELL 250' ft. WELL'S STATIC WATER LEVEL 172' ft WELL WAS USED AS:	
		<input type="checkbox"/> Domestic <input type="checkbox"/> Public Water Supply <input checked="" type="checkbox"/> Irrigation <input type="checkbox"/> Oil Field Water Supply <input type="checkbox"/> Feedlot <input type="checkbox"/> Domestic (Lawn & Garden) <input type="checkbox"/> Industrial <input type="checkbox"/> Air Conditioning <input type="checkbox"/> Dewatering <input type="checkbox"/> Monitoring <input type="checkbox"/> Injection Well <input type="checkbox"/> Other _____	
Was a chemical/bacteriological sample submitted to Department? Yes <input type="checkbox"/> No <input checked="" type="checkbox"/>	
5 TYPE OF BLANK CASING USED:	
<input checked="" type="checkbox"/> Steel <input type="checkbox"/> RMP (SR) <input type="checkbox"/> Wrought <input type="checkbox"/> Fiberglass <input type="checkbox"/> PVC <input type="checkbox"/> ABS <input type="checkbox"/> Asbestos-Cement <input type="checkbox"/> Concrete Tile <input type="checkbox"/> Other (Specify below) _____	
Blank casing diameter 16" in. Was casing pulled? Yes <input checked="" type="checkbox"/> No <input type="checkbox"/> If yes, how much 60" Casing height above or below land surface Below 60" in.	
6 GROUT PLUG MATERIAL: <input type="checkbox"/> Neat cement <input checked="" type="checkbox"/> Cement grout <input type="checkbox"/> Bentonite <input type="checkbox"/> Other _____	
Grout Plug Intervals: From 10' ft. to 5' ft., From _____ ft. to _____ ft., From _____ to _____ ft.	
What is the nearest source of possible contamination:	
<input type="checkbox"/> Septic tank <input type="checkbox"/> Sewer lines <input type="checkbox"/> Watertight sewer lines <input type="checkbox"/> Lateral lines <input type="checkbox"/> Cess pool		<input type="checkbox"/> Seepage pit <input type="checkbox"/> Pit privy <input type="checkbox"/> Sewage lagoon <input type="checkbox"/> Feedyard <input type="checkbox"/> Livestock pens		<input type="checkbox"/> Fuel Storage <input type="checkbox"/> Fertilizer storage <input type="checkbox"/> Insecticide storage <input type="checkbox"/> Abandoned water well <input type="checkbox"/> Oil well/Gas well	
<input type="checkbox"/> Other (specify below) None Observed Direction from well? _____ How many feet? _____	
<table border="1"> <thead> <tr> <th>FROM</th> <th>TO</th> <th>PLUGGING MATERIALS</th> <th>FROM</th> <th>TO</th> <th>PLUGGING MATERIALS</th> </tr> </thead> <tbody> <tr> <td>250'</td> <td>170'</td> <td>Chlorinated Road Sand</td> <td>170'</td> <td>10'</td> <td>Dirty oversized rock w/clay chunks</td> </tr> <tr> <td>10'</td> <td>5'</td> <td>3,000 PSI Concrete</td> <td>5'</td> <td>0'</td> <td>Cut casing off and backfilled</td> </tr> <tr><td> </td><td> </td><td> </td><td> </td><td> </td><td> </td></tr>
7 CONTRACTOR'S OR LANDOWNER'S CERTIFICATION: This water well was plugged under my jurisdiction and was completed on (mo/day/year) 9-3-2013 and this record is true to the best of my knowledge and belief. Kansas Water Well Contractor's License No. 145. This Water Well Record was completed on (mo/day/year) 9-30-2013 under the business name of Hydro Resources Mid Continent by (signature) Gary Clepper 	
INSTRUCTIONS: Use typewriter or ballpoint pen. Please press firmly and print clearly. Please fill in blanks, underline or circle the correct answers. Send top three copies to Kansas Department of Health and Environment, Bureau of Water, Geology Section, 1000 SW Jackson St., Ste. 420, Topeka, Kansas 66612-1367. Telephone: 785/296-5524. Send one to Water Well Owner and retain one for your records. Visit us at <a href="http://www.kdheks.gov/waterwell/index.html">http://www.kdheks.gov/waterwell/index.html</a> .	
Check one: <input type="checkbox"/> White Copy <input type="checkbox"/> Blue Copy <input type="checkbox"/> Pink Copy	