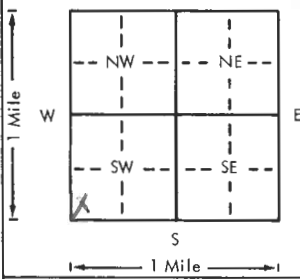


USE TYPEWRITER OR BALL
POINT PEN-PRESS FIRMLY,
PRINT CLEARLY.

WATER WELL RECORD
KSA 82a-1201-1215

Kansas Department of Health and
Environment-Division of Environment
(Water well Contractors)
Topeka, Kansas 66620

1. Location of well: County <u>Sedgwick</u>		Fraction <u>SW 1/4 SW 1/4 SW 1/4</u>	Section number <u>22</u>	Township number <u>T 29 S R 3 E W</u>	Range number
2. Distance and direction from nearest town or city: <u>1 1/8 North of Viola, Kansas</u>			3. Owner of well: <u>Dale Miller</u>		
Street address of well location if in city: <u>Diagonal on East side of Road.</u>			City, state, zip code: <u>Viola, Kansas 67449</u>		
4. Locate with "X" in section below: 			6. Bore hole dia. <u>11</u> in. Completion date <u>9-19-75</u> Well depth <u>60</u> ft.		
5. Type and color of material			7. ☒ Cable tool ☒ Rotary ☐ Driven ☐ Dug ☐ Hollow rod ☐ Jetted ☐ Bored ☐ Reverse rotary		
			8. Use: ☒ Domestic ☐ Public supply ☐ Industry ☐ Irrigation ☐ Air conditioning ☐ Stock ☐ Lawn ☐ Oil field water ☐ Other		
			9. Casing: Material <u>Steel</u> Height: Above or below Threaded ☐ Welded ☒ Surface <u>12</u> in. RMP <u>1</u> PVC ☐ Weight <u>12</u> lbs./ft. Dia. <u>5</u> in. to <u>60</u> ft. depth Wall Thickness: inches or Dia. <u>5</u> in. to <u>60</u> ft. depth gage No. <u>200</u>		
			10. Screen: Manufacturer's name <u>Sunflower Plastic</u> Type <u>Step</u> Dia. <u>5</u> in. Slot/gauze <u>0.050</u> Length <u>40</u> ft. Set between <u>20</u> ft. and <u>60</u> ft. Gravel pack <u>1/2</u> ft. and <u>1 1/4</u> ft. Size range of material <u>1/4-1/8</u> in.		
11. Static water level: <u>12</u> ft. below land surface Date <u>9-19-75</u>			12. Pumping level below land surfaces: ____ ft. after ____ hrs. pumping ____ g.p.m. ____ ft. after ____ hrs. pumping ____ g.p.m. Estimated maximum yield ____ g.p.m.		
13. Water sample submitted: ____ Yes ____ No Date ____			14. Well head completion: <u>12</u> capped ____ Pitless adapter ____ Inches above grade		
15. Well grouted? <u>yes</u> With: ____ Neat cement ____ Bentonite ☒ Concrete Depth: From <u>10</u> ft. to <u>14</u> ft.			16. Nearest source of possible contamination: ft. <u>60</u> Direction <u>NORTH</u> Type <u>Trunk</u> Well disinfected upon completion? ☒ Yes ____ No		
17. Pump: ☒ Not installed Manufacturer's name ____ Model number ____ HP ____ Volts ____ Length of drop pipe ____ ft. capacity ____ g.p.m. Type: ____ Submersible ____ Turbine ____ Jet ____ Reciprocating ____ Centrifugal ____ Other			20. Water well contractor's certification: This well was drilled under my jurisdiction and this report is true to the best of my knowledge and belief. <u>Narp Well Pump 236</u> Business name <u>Trichita, Kansas</u> License No. ____ Address <u>M. Arnold</u> Date <u>9-22-75</u> Signed <u>M. Arnold</u> Authorized representative		
18. Elevation:		19. Remarks: <u>Flat Ground</u>			
Topography: ____ Hill ____ Slope ____ Upland ____ Valley					

Forward the white, blue and pink copies to the Department of Health and Environment

Form WWC-5