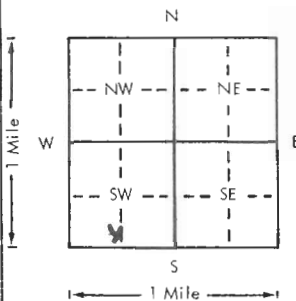


USE TYPEWRITER OR BALL
POINT PEN-PRESS FIRMLY,
PRINT CLEARLY.

WATER WELL RECORD
KSA 82a-1201-1215

Kansas Department of Health and
Environment-Division of Environment
(Water well Contractors)
Topeka, Kansas 66620

1. Location of well:		County <u>Sedgwick</u>	Fraction <u>SE 1/4 SW 1/4</u>	Section number <u>31</u>	Township number <u>T 29</u>	Range number <u>S R 3W</u>
2. Distance and direction from nearest town or city: <u>3 1/4 E., of the</u>		3. Owner of well: <u>Kirk Chambers</u>		Street address of well location if in city: <u>Viola, Kansas</u>		
Street address of well location if in city: <u>Viola, Kansas</u>		City, state, zip code: <u>Viola, Kansas</u>				
4. Locate with "X" in section below:		Sketch map:		6. Bore hole dia. <u>12</u> in. Completion date <u>3-24-77</u>		
		<u>on 119th St. So. on the north side of the road.</u>		Well depth <u>90</u> ft.		
5. Type and color of material		From	To	7. ☒ Cable tool ☒ Rotary ☐ Driven ☐ Dug		
<u>Topsoil</u>		<u>0</u>	<u>3</u>	☐ Hollow rod ☐ Jetted ☐ Bored ☐ Reverse rotary		
<u>Clay</u>		<u>3</u>	<u>15</u>	8. Use: ☒ Domestic ☐ Public supply ☐ Industry		
<u>Shale</u>		<u>15</u>	<u>90</u>	☐ Irrigation ☐ Air conditioning ☐ Stock		
				☐ Lawn ☐ Oil field water ☐ Other		
				9. Casing: Material <u>stiprene</u> Height above or below surface <u>12</u> in.		
				Threaded ☒ Welded ☐ RMP ☐ PVC Weight <u>12</u> lbs./ft.		
				Dia <u>5</u> in. to <u>90</u> ft. depth Wall Thickness: inches or		
				Dia. <u>5</u> in. to <u>90</u> ft. depth gage No. <u>200</u>		
				10. Screen: Manufacturer's name <u>Sunflower Plastic</u>		
				Type <u>stiprene</u> Dia. <u>5</u> in.		
				Slit/gauze <u>106</u> Length <u>70</u> ft.		
				Set between <u>20</u> ft. and <u>90</u> ft.		
				Gravel pack? <u>yes</u> Size range of material <u>1/4 - 1/8"</u>		
				11. Static water level: <u>15</u> ft. below land surface Date <u>3-24-77</u>		
				12. Pumping level below land surfaces:		
				____ ft. after ____ hrs. pumping ____ g.p.m.		
				____ ft. after ____ hrs. pumping ____ g.p.m.		
				Estimated maximum yield ____ g.p.m.		
				13. Water sample submitted: ____ mo./day/yr.		
				☐ Yes ☐ No Date ____		
				14. Well head completion: <u>12 cased</u>		
				☐ Pitless adapter <u>12</u> inches above grade		
				15. Well grouted? <u>yes</u>		
				With: ☐ Neat cement ☐ Bentonite ☒ Concrete		
				Depth: From <u>40</u> ft. to <u>14</u> ft.		
				16. Nearest source of possible contamination: <u>septic tank</u>		
				ft. <u>100</u> Direction <u>NE</u> Type <u>septic tank</u>		
				Well disinfected upon completion? ☒ Yes ☐ No		
				17. Pump: ☒ Not installed		
				Manufacturer's name ____		
				Model number ____ HP ____ Volts ____		
				Length of drop pipe ____ ft. capacity ____ g.p.m.		
				Type: ☐ Submersible ☐ Turbine		
				☐ Jet ☐ Reciprocating		
				☐ Centrifugal ☐ Other		
18. Elevation:		19. Remarks:		20. Water well contractor's certification:		
Topography: ☐ Hill ☐ Slope ☒ Upland ☒ Valley				This well was drilled under my jurisdiction and this report is true to the best of my knowledge and belief.		
				<u>Harp Well - Pump 236</u>		
				Business name <u>Wichita, Ks</u> License No. ____		
				Address <u>Wichita, Ks</u>		
				Signed <u>W. Arnold</u> Date <u>3-28-77</u>		
				Authorized representative		