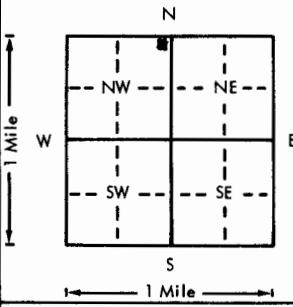


USE TYPEWRITER OR BALL
POINT PEN-PRESS FIRMLY,
PRINT CLEARLY.

WATER WELL RECORD
KSA 82a-1201-1215

Kansas Department of Health and
Environment-Division of Environment
(Water well Contractors)
Topeka, Kansas 66620

1. Location of well:	County Gray	Fraction NE 1/4 NE 1/4 NW 1/4	Section number 1	Township number T 29 S R 30 E/W	Range number
2. Distance and direction from nearest town or city: 3 1/2 NE 1/4 E of Copeland, KS.	3. Owner of well: Joe Sturk				
Street address of well location if in city: Sublette, KS. 67877					
4. Locate with "X" in section below:		Sketch map:			6. Bore hole dia. 9 in. Completion date 11/4/75 Well depth 200 ft.
					7. <input checked="" type="checkbox"/> Cable tool <input checked="" type="checkbox"/> Rotary <input type="checkbox"/> Driven <input type="checkbox"/> Dug <input type="checkbox"/> Hollow rod <input type="checkbox"/> Jetted <input type="checkbox"/> Bored <input type="checkbox"/> Reverse rotary
					8. Use: <input checked="" type="checkbox"/> Domestic <input type="checkbox"/> Public supply <input type="checkbox"/> Industry <input type="checkbox"/> Irrigation <input type="checkbox"/> Air conditioning <input type="checkbox"/> Stock <input type="checkbox"/> Lawn <input type="checkbox"/> Oil field water <input type="checkbox"/> Other
					9. Casing: Material PITS Height: Above or below Threaded <input type="checkbox"/> Welded 91 Surface 14 in. RMP X PVC <input type="checkbox"/> Weight 0.320 lbs./ft. Dia. 5 in. to 160 ft. depth Wall Thickness: inches or Dia. 5 in. to ft. depth gage No. 0.320
5. Type and color of material		From 0	To 68	10. Screen: Manufacturer's name J+L Type RMP Dia. 5" Slot/gauze 1/16 Length 40 Set between 160 ft. and 200 ft. ft. and ft. Gravel pack? Yes Size range of material 18	
				11. Static water level: 68 ft. below land surface Date 11/4/75	
				12. Pumping level below land surfaces: ft. after hrs. pumping g.p.m. ft. after hrs. pumping g.p.m. Estimated maximum yield 100 g.p.m.	
				13. Water sample submitted: Yes Date 11/4/75	
				14. Well head completion: Pitless adapter 14 Inches above grade	
				15. Well grouted? Yes With: <input checked="" type="checkbox"/> Neat cement <input type="checkbox"/> Bentonite <input type="checkbox"/> Concrete Depth: From 3 ft. to 13 ft.	
				16. Nearest source of possible contamination: ft. 120 Direction SW Type Septic Well disinfected upon completion? Yes No	
				17. Pump: <input checked="" type="checkbox"/> Not installed Manufacturer's name T+L Water Well Model number 142 HP 1/2 Volts 110 Length of drop pipe ft. capacity g.p.m. Type: <input type="checkbox"/> Submersible 142 Turbine <input type="checkbox"/> Jet 142 Reciprocating <input type="checkbox"/> Centrifugal 142 Other	
		(Use a second sheet if needed)			
18. Elevation:	19. Remarks: Well to be completed by: Dunham Drilling Copeland, KS.				
Topography: <input type="checkbox"/> Hill <input type="checkbox"/> Slope <input checked="" type="checkbox"/> Upland <input type="checkbox"/> Valley	20. Water well contractor's certification: This well was drilled under my jurisdiction and this report is true to the best of my knowledge and belief. T+L Water Well 142 Business name Box 816 Liberal, KS License No. Address Box 816 Liberal, KS Signed John Waggoner Date 11/4/75 Authorized representative				