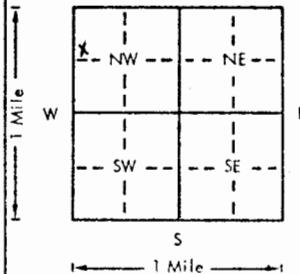


USE TYPEWRITER OR BALL  
POINT PEN-PRESS FIRMLY,  
PRINT CLEARLY.

WATER WELL RECORD  
KSA 82a-1201-1215

Kansas Department of Health and  
Environment-Division of Environment  
(Water well Contractors)  
Topeka, Kansas 66620

|  |   |                                      |  |                                 |   |  |   |
|--|---|--------------------------------------|--|---------------------------------|---|--|---|
| 1. Location of well:   | County <b>GRAY</b>                          | Fraction <b>SW 1/4 NW 1/4 NW 1/4</b> | Section number <b>4</b>  | Township number <b>1 29 S R</b> | Range number <b>30 E/W</b>  |  |   |
| 2. Distance and direction from nearest town or city:<br><b>IN Copeland 1E 1/4 N</b>  | Street address of well location if in city: |                                      | 3. Owner of well: <b>Mildred REED</b><br>R.R. or street: <b>R 2 Box 43</b> |                                 |   |  |   |
| 4. Locate with "X" in section below:<br><br> |   |                                      | Sketch map:  |                                 |   |  |   |
| 5. Type and color of material<br><br><b>overburden</b>   |   |                                      | From <b>0</b>  | To <b>160</b>                   | 6. Bore hole dia. <b>9</b> in. Completion date <b>8/23/80</b><br>Well depth <b>280</b> ft.  |  |   |
| <b>medium sand+ gravel</b>   |   |                                      | From <b>160</b>  | To <b>220</b>                   | 7. <input checked="" type="checkbox"/> Cable tool <input checked="" type="checkbox"/> Rotary <input type="checkbox"/> Driven <input type="checkbox"/> Dug<br><input type="checkbox"/> Hollow rod <input checked="" type="checkbox"/> Jetted <input type="checkbox"/> Bored <input type="checkbox"/> Reverse rotary  |  |   |
| <b>medium sand+ clay</b>   |   |                                      | From <b>220</b>  | To <b>280</b>                   | 8. Use: <input type="checkbox"/> Domestic <input type="checkbox"/> Public supply <input type="checkbox"/> Industry<br><input type="checkbox"/> Irrigation <input type="checkbox"/> Air conditioning <input checked="" type="checkbox"/> Stock<br><input type="checkbox"/> Lawn <input type="checkbox"/> Oil field water <input type="checkbox"/> Other  |  |   |
|  |   |                                      | From <b>0</b>  | To <b>160</b>                   | 9. Casing: Material <b>PVC</b> Height: Above or below<br>Threaded <input type="checkbox"/> Welded Surface <b>14</b> in.<br>RMP <b>PVC glue</b> Weight <b>558</b> lbs./ft.<br>Dia. <b>5</b> in. to <b>20</b> ft. depth Wall thickness: inches or<br>Dia. <b>5</b> in. to <b>14</b> ft. depth gauge No. <b>C-58</b>   |  |   |
|  |   |                                      | From <b>160</b>  | To <b>220</b>                   | 10. Screen: Manufacturer's name <b>FEERLESS</b><br>Type <b>PVC</b> Dia. <b>5"</b><br>Slat/gauge <b>1/16</b> Length <b>160</b> ft.<br>Set between <b>20</b> ft. and <b>280</b> ft.<br>ft. and <b>14</b> ft.<br>Gravel pack? <input checked="" type="checkbox"/> Yes Size range of material <b>178</b>  |  |   |
|  |   |                                      | From <b>220</b>  | To <b>280</b>                   | 11. Static water level: <b>160</b> ft. below land surface Date <b>8/23/80</b>   |  |   |
|  |   |                                      | From <b>0</b>  | To <b>160</b>                   | 12. Pumping level below land surfaces:<br>ft. after <b>0</b> hrs. pumping <b>0</b> g.p.m.<br>ft. after <b>0</b> hrs. pumping <b>0</b> g.p.m.<br>Estimated maximum yield <b>50</b> g.p.m.  |  |   |
|  |   |                                      | From <b>160</b>  | To <b>220</b>                   | 13. Water sample submitted: <b>0</b> mo./day/yr.<br>Yes <input checked="" type="checkbox"/> No <b>Date</b>  |  |   |
|  |   |                                      | From <b>220</b>  | To <b>280</b>                   | 14. Well head completion: <b>14</b> inches above grade<br><input type="checkbox"/> Pitless adapter  |  |   |
|  |   |                                      | From <b>0</b>  | To <b>160</b>                   | 15. Well grouted? <input checked="" type="checkbox"/><br>With: <input checked="" type="checkbox"/> Neat cement <input type="checkbox"/> Bentonite <input type="checkbox"/> Concrete<br>Depth: From <b>3</b> ft. to <b>13</b> ft.  |  |   |
|  |   |                                      | From <b>160</b>  | To <b>220</b>                   | 16. Nearest source of possible contamination:<br>ft. <b>0</b> Direction <b>0</b> Type <b>0</b><br>Well disinfected upon completion? <input checked="" type="checkbox"/> Yes <input checked="" type="checkbox"/> No  |  |   |
|  |   |                                      | From <b>220</b>  | To <b>280</b>                   | 17. Pump: <input checked="" type="checkbox"/> Not installed<br>Manufacturer's name <b>TLC Water Well Service</b><br>Model number <b>142</b> HP <b>1/2</b> Volts <b>115</b><br>Length of drop pipe <b>0</b> ft. capacity <b>0</b> g.p.m.<br>Type:<br><input type="checkbox"/> Submersible <input type="checkbox"/> Turbine<br><input type="checkbox"/> Jet <input type="checkbox"/> Reciprocating<br><input type="checkbox"/> Centrifugal <input type="checkbox"/> Other |  |   |
| (Use a second sheet if needed)   |   |                                      | From <b>0</b>  | To <b>160</b>                   | 18. Elevation: <b>0</b><br>Topography:<br><input type="checkbox"/> Hill<br><input type="checkbox"/> Slope<br><input checked="" type="checkbox"/> Upland<br><input type="checkbox"/> Valley  | 19. Remarks: <b>Pump to be installed by<br/>Dunham Drilling Copeland KS.</b> | 20. Water well contractor's certification:<br>This well was drilled under my jurisdiction and this report<br>is true to the best of my knowledge and belief.<br><b>TLC Water Well Service 142</b><br>Business name <b>816 Industrial</b> License No. <b>K36701</b><br>Address <b>Box 43 Copeland KS</b><br>Signed <b>John W. Dunham</b> Date <b>9/3/80</b><br>Authorized representative |