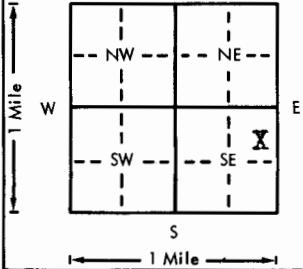


USE TYPEWRITER OR BALL  
POINT PEN-PRESS FIRMLY,  
PRINT CLEARLY.

WATER WELL RECORD  
KSA 82a-1201-1215

Kansas Department of Health and  
Environment-Division of Environment  
(Water well Contractors)  
Topeka, Kansas 66620

| 1. Location of well:  | County  | Fraction   | Section number   | Township number  | Range number  |
|---|---|--|--|--|---|
|   | Gray  | SE 1/4 <b>NE 1/4 SE 1/4</b>  | 8  | T 29   | S R 30  |
| 2. Distance and direction from nearest town or city:<br>Street address of well location if in city: | half mile east<br>and 2 blocks south of<br>Copeland |  | 3. Owner of well:<br>R.R. or street:<br>City, state, zip code:   | Bert Rodgers<br>2804 Derends Drive<br>Hutchinson, Kansas 67501 |   |
| 4. Locate with "X" in section below:  | Sketch map:   |  | 6. Bore hole dia. ____ in. Completion date <b>6-2-76</b><br>Well depth <b>375</b> ft.  |  |   |
|                    |   | 7. <input type="checkbox"/> Cable tool <input type="checkbox"/> Rotary <input type="checkbox"/> Driven <input type="checkbox"/> Dug<br><input type="checkbox"/> Hollow rod <input type="checkbox"/> Jetted <input type="checkbox"/> Bored <input checked="" type="checkbox"/> Reverse rotary |  |  | 8. Use: <input checked="" type="checkbox"/> Domestic <input type="checkbox"/> Public supply <input type="checkbox"/> Industry<br><input checked="" type="checkbox"/> Irrigation <input type="checkbox"/> Air conditioning <input type="checkbox"/> Stock<br><input type="checkbox"/> Lawn <input type="checkbox"/> Oil field water <input type="checkbox"/> Other |
| 5. Type and color of material   | From 0 To 30  |  | 9. Casing: Material <b>Steel</b> Height: Above or <b>12"</b><br>Threaded <input type="checkbox"/> Welded <input checked="" type="checkbox"/> Surface <b>12"</b> in.<br>RMP <input type="checkbox"/> PVC <input type="checkbox"/> Weight <input type="checkbox"/> lbs./ft.<br>Dia. ____ in. to ____ ft. depth Wall Thickness: inches or<br>Dia. ____ in. to ____ ft. depth gage No. ____  |  |   |
| Topsoil & clay  | 30 60   |  | 10. Screen: Manufacturer's name <b>W. A. Brown Ent.</b><br>Type <b>Bridge</b> Dia. <b>16"</b><br>Slot/gauze <b>Slot</b> Length <b>2"</b><br>Set between <b>275</b> ft. and <b>375</b> ft.<br>ft. and ____ ft.<br>Gravel pack? <input checked="" type="checkbox"/> Yes Size range of material <b>5/8</b>  |  |   |
| Clay & Little Lime  | 60 69   |  | 11. Static water level: mo./day/yr.<br><b>145</b> ft. below land surface Date <b>6-21-76</b>   |  |   |
| Sand  | 69 90   |  | 12. Pumping level below land surfaces: Not Test Pumped<br>ft. after ____ hrs. pumping ____ g.p.m.<br>ft. after ____ hrs. pumping ____ g.p.m.<br>Estimated maximum yield ____ g.p.m.  |  |   |
| Clay & Little Lime  | 90 138  |  | 13. Water sample submitted: mo./day/yr.<br><input type="checkbox"/> Yes <input checked="" type="checkbox"/> No Date ____   |  |   |
| Sand & little clay  | 138 150   |  | 14. Well head completion:<br><input type="checkbox"/> Pitless adapter <b>12</b> Inches above grade   |  |   |
| Clay  | 150 165   |  | 15. Well grouted? <input checked="" type="checkbox"/> Yes<br>With: <input checked="" type="checkbox"/> Neat cement <input type="checkbox"/> Bentonite <input type="checkbox"/> Concrete<br>Depth: From <b>0</b> ft. to <b>10</b> ft.   |  |   |
| Sand & clay   | 165 177   |  | 16. Nearest source of possible contamination: None<br>ft. ____ Direction ____ Type ____<br>Well disinfected upon completion? <input checked="" type="checkbox"/> Yes <input type="checkbox"/> No   |  |   |
| Gum Clay & Little cemented sand   | 177 210   |  | 17. Pump:<br>Manufacturer's name <b>WINTHROATH</b> Not installed<br>Model number <b>1954</b> HP <b>125</b> Volts ____<br>Length of drop pipe <b>290</b> ft. capacity <b>1280</b> g.p.m.<br>Type:<br><input type="checkbox"/> Submersible <input checked="" type="checkbox"/> Turbine<br><input type="checkbox"/> Jet <input type="checkbox"/> Reciprocating<br><input type="checkbox"/> Centrifugal <input type="checkbox"/> Other |  |   |
| Sand & little cemented sand   | 210 240   |  | 18. Elevation: 19. Remarks:<br><br>Topography:<br><input type="checkbox"/> Hill<br><input checked="" type="checkbox"/> Slope<br><input type="checkbox"/> Upland<br><input type="checkbox"/> Valley<br><br>Machined Leveled   |  |   |
| Coarse sand and little cemented sand  | 240 296   |  | 20. Water well contractor's certification:<br>This well was drilled under my jurisdiction and this report<br>is true to the best of my knowledge and belief.<br>Dunham Drilling Co. <b>223</b><br>Business name _____ License No. _____<br>Address <b>Copeland, Kansas</b><br>Signed <b>Don Dunham</b> Date <b>7-2-76</b><br>Authorized representative _____   |  |   |
| Very hard cemented sand   | 296 297   |  |  |  |   |
| Gum clay & little cemented sand   | 297 305   |  |  |  |   |
| Little Fine Sand  | 305 314   |  |  |  |   |
| Lime & clay   | 314 319   |  |  |  |   |
| Sand & clay   | 319 337   |  |  |  |   |
| Very hard cemented sand   | 337 338   |  |  |  |   |
| Gume Clay   | 338 341   |  |  |  |   |
| Very hard lime  | 341 342   |  |  |  |   |
| Sand & little cemented sand   | 342 357   |  |  |  |   |
| Clay  | 357 360   |  |  |  |   |
| Sand & Clay   | 360 375   |  |  |  |   |
| Gum Clay & blue (Use a second sheet if needed)  | 375 386   |  |  |  |   |