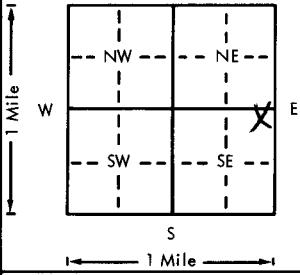


USE TYPEWRITER OR BALL
POINT PEN-PRESS FIRMLY,
PRINT CLEARLY.

WATER WELL RECORD
KSA 82a-1201-1215

Kansas Department of Health and
Environment-Division of Environment
(Water well Contractors)
Topeka, Kansas 66620

1. Location of well: County Gray	Fraction NE 1/4 NE 1/4 SE 1/4	Section number 26	Township number T 29 S	Range number R 30 W
2. Distance and direction from nearest town or city: 3 west , 7 1/2 south 2 1/2 west of Montezuma Street address of well location if in city:	3. Owner of well: Lois Johnson R.R. or street: 3380 Yarrow City, state, zip code: Wheatridge, Colo. 80033			
4. Locate with "X" in section below: 	Sketch map:	6. Bore hole dia. 2 1/2 in. Completion date 10-17-76 Well depth 365 ft.		
7. <input type="checkbox"/> Cable tool <input type="checkbox"/> Rotary <input type="checkbox"/> Driven <input type="checkbox"/> Dug <input type="checkbox"/> Hollow rod <input type="checkbox"/> Jetted <input type="checkbox"/> Bored <input checked="" type="checkbox"/> Reverse rotary				
8. Use: <input type="checkbox"/> Domestic <input type="checkbox"/> Public supply <input type="checkbox"/> Industry <input checked="" type="checkbox"/> Irrigation <input type="checkbox"/> Air conditioning <input type="checkbox"/> Stock <input type="checkbox"/> Lawn <input type="checkbox"/> Oil field water <input type="checkbox"/> Other				
9. Casing: Material steel Height: Above or below Threaded <input type="checkbox"/> Welded <input checked="" type="checkbox"/> Surface 12 in. RMP 1000 PVC 1000 Weight 36.87 lbs./ft. Dia. 16 in. to 366 ft. depth Wall Thickness: inches or Dia. 16 in. to ft. depth gage No. 1				
10. Screen: Manufacturer's name NO SCREEN Type Dia. Slot/gauze Length Set between 200-165 ft. and ft. Perf: 200-165 ft. and ft. Gravel pack? yes Size range of material 1/2" Down				
11. Static water level: 170 ft. below land surface Date 9-22-76 mo./day/yr.				
12. Pumping level below land surfaces: 205 ft. after 3 hrs. pumping 2450 g.p.m. ft. after hrs. pumping g.p.m. Estimated maximum yield 2450 g.p.m.				
13. Water sample submitted: no Date mo./day/yr. yes <input checked="" type="checkbox"/> No Date 				
14. Well head completion: <input type="checkbox"/> Pitless adapter 12 inches above grade				
15. Well grouted? yes With: <input type="checkbox"/> Neat cement <input type="checkbox"/> Bentonite <input checked="" type="checkbox"/> Concrete Depth: From 0 ft. to 10 ft.				
16. Nearest source of possible contamination: N/A ft. Direction Type Field Well disinfected upon completion? yes <input checked="" type="checkbox"/> No				
17. Pump: Manufacturer's name Goulds U.S. Pumps Not installed Model number 14JHC HP 200 Volts 115 Length of drop pipe 220 ft. capacity 1000 g.p.m. Type: <input type="checkbox"/> Submersible <input checked="" type="checkbox"/> Turbine <input type="checkbox"/> Jet <input type="checkbox"/> Reciprocating <input type="checkbox"/> Centrifugal <input type="checkbox"/> Other				
18. Elevation: Topography: <input type="checkbox"/> Hill <input checked="" type="checkbox"/> Slope <input type="checkbox"/> Upland <input type="checkbox"/> Valley				
19. Remarks: (Use a second sheet if needed)				
20. Water well contractor's certification: This well was drilled under my jurisdiction and this report is true to the best of my knowledge and belief. Minter Wilson Drilling 208 Business name Box A Garden City, KS License No. 67346 Address 1-36-7 Signed John Minter Date 7/26/76 Authorized representative John Minter				

Pro
Professionals **MINTER-WILSON DRILLING CO.** INCORPORATED

Irrigation
and Domestic
Water Systems
Complete Installation
and Repairing

Phone 276-8269 • P.O. Box 493 • GARDEN CITY, KANSAS 67846

CLYDE PORPE
GRAY COUNTY
8-11-76

Location: SE 1/4 36-29-30 South west corner of $\frac{1}{4}$
Static Water Level- 174'

Test #3

0	4	Top soil
4	36	Brown clay
36	63	Brown sandy clay
63	94	Fine to med. sand and gravel
94	109	Brown clay
109	127	Fine to med. sand and gravel
127	139	Brown clay
139	205	Fine to med. sand and gravel
205	234	Brown and blue clay
234	364	Fine to med. sand and gravel
364	380	Brown clay and white rock

T.D. 365'