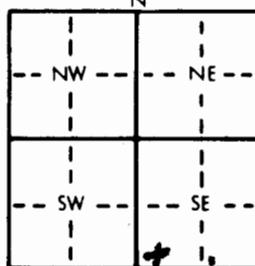
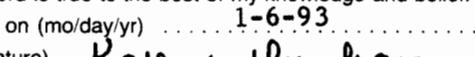


1 LOCATION OF WATER WELL:		Fraction SW 1/4 SW 1/4 SE 1/4	Section Number 26	Township Number T 29 S	Range Number R 30 E/W	
Distance and direction from nearest town or city street address of well if located within city? 3 miles south 2 3/4 Mile East of Copeland, Kansas	
2 WATER WELL OWNER: Mr. Edward K. Tyler RR#, St. Address, Box # : Route 2 Box 73 City, State, ZIP Code : Copeland, Kansas 67837			Board of Agriculture, Division of Water Resources Application Number:	
3 LOCATE WELL'S LOCATION WITH AN "X" IN SECTION BOX:		4 DEPTH OF COMPLETED WELL 409 ft. ELEVATION:	
		Depth(s) Groundwater Encountered 1. 181 ft. 2. 375 ft. 3. ft. WELL'S STATIC WATER LEVEL 181 ft. below land surface measured on mo/day/yr 11-17-92 Pump test data: Well water was ft. after hours pumping gpm Est. Yield 10 gpm: Well water was ft. after hours pumping gpm Bore Hole Diameter 10 in. to 409 ft. and in. to ft. WELL WATER TO BE USED AS: 5 Public water supply 8 Air conditioning 11 Injection well 1 Domestic 3 Feedlot 6 Oil field water supply 9 Dewatering 12 Other (Specify below) Water Livestock 2 Irrigation 4 Industrial 7 Lawn and garden only 10 Monitoring well Was a chemical/bacteriological sample submitted to Department? Yes No If yes, mo/day/yr sample was submitted Water Well Disinfected? Yes <input checked="" type="checkbox"/> No <input type="checkbox"/>	
5 TYPE OF BLANK CASING USED:		5 Wrought iron 1 Steel 3 RMP (SR) 2 PVC 4 ABS	8 Concrete tile 6 Asbestos-Cement 7 Fiberglass	CASING JOINTS: Glued Clamped Welded Threaded	
Blank casing diameter 5 in. to 368 ft., Dia in. to ft., Dia in. to ft.		lbs./ft. Wall thickness or gauge No. 0-200 SSDR21 ft.	
Casing height above land surface 24" in., weight		200-409 SSDR17	
TYPE OF SCREEN OR PERFORATION MATERIAL:	
1 Steel 3 Stainless steel 2 Brass 4 Galvanized steel		5 Fiberglass 6 Concrete tile	7 PVC 8 RMP (SR) 9 ABS	10 Asbestos-cement 11 Other (specify) 12 None used (open hole)	
SCREEN OR PERFORATION OPENINGS ARE:	
1 Continuous slot 3 Mill slot 2 Louvered shutter 4 Key punched		5 Gauzed wrapped 6 Wire wrapped 7 Torch cut	8 Saw cut 9 Drilled holes 10 Other (specify)	11 None (open hole)	
SCREEN-PERFORATED INTERVALS: From 369 ft. to 409 ft., From ft. to ft.	
From ft. to ft., From ft. to ft., From ft. to ft.	
GRAVEL PACK INTERVALS: From 20 ft. to 409 ft., From ft. to ft., From ft. to ft.	
6 GROUT MATERIAL: 1 Neat cement 2 Cement grout		3 Bentonite	4 Other	
Grout Intervals: From 0 ft. to 20 ft., From ft. to ft., From ft. to ft.	
What is the nearest source of possible contamination:	
1 Septic tank 4 Lateral lines 2 Sewer lines 5 Cess pool 3 Watertight sewer lines 6 Seepage pit		7 Pit privy 8 Sewage lagoon 9 Feedyard	10 Livestock pens 11 Fuel storage 12 Fertilizer storage 13 Insecticide storage	14 Abandoned water well 15 Oil well/Gas well 16 Other (specify below)	
Direction from well? North downhill		How many feet? 50'	
<table border="1"> <thead> <tr> <th>FROM</th> <th>TO</th> <th>LITHOLOGIC LOG</th> <th>FROM</th> <th>TO</th> <th>PLUGGING INTERVALS</th> </tr> </thead> <tbody> <tr><td>0</td><td>60</td><td>Topsoil & clay & little lime</td><td>375</td><td>385</td><td>Sand & clay</td></tr> <tr><td>60</td><td>90</td><td>Clay & little lime & little sand</td><td>385</td><td>390</td><td>Lime & clay</td></tr> <tr><td>90</td><td>120</td><td>Sand & little clay</td><td>390</td><td>400</td><td>Clay & lime</td></tr> <tr><td>120</td><td>135</td><td>Sand</td><td>400</td><td>405</td><td>Lime (very hard)</td></tr> <tr><td>135</td><td>150</td><td>Sand & little clay</td><td>405</td><td>410</td><td>Lime (very hard)</td></tr> <tr><td>150</td><td>165</td><td>Sand & little cemented sand</td><td></td><td></td><td></td></tr> <tr><td>165</td><td>171</td><td>Sand</td><td></td><td></td><td></td></tr> <tr><td>171</td><td>180</td><td>Clay & little lime</td><td></td><td></td><td></td></tr> <tr><td>180</td><td>195</td><td>Clay & sand</td><td></td><td></td><td></td></tr> <tr><td>195</td><td>210</td><td>Sand & clay</td><td></td><td></td><td></td></tr> <tr><td>210</td><td>332</td><td>Clay (blue)</td><td></td><td></td><td></td></tr> <tr><td>332</td><td>334</td><td>Clay & little lime (blue)</td><td></td><td></td><td></td></tr> <tr><td>334</td><td>345</td><td>Clay (blue)</td><td></td><td></td><td></td></tr> <tr><td>345</td><td>360</td><td>Clay & little lime (blue)</td><td></td><td></td><td></td></tr> <tr><td>360</td><td>375</td><td>Clay & little lime</td><td></td><td></td><td></td></tr>
7 CONTRACTOR'S OR LANDOWNER'S CERTIFICATION: This water well was (1) constructed, (2) reconstructed, or (3) plugged under my jurisdiction and was completed on (mo/day/year) 11-17-92 and this record is true to the best of my knowledge and belief. Kansas Water Well Contractor's License No. 223 This Water Well Record was completed on (mo/day/yr) 1-6-93	
under the business name of Dunham Drilling Company by (signature) 	

INSTRUCTIONS: Use typewriter or ball point pen. PLEASE PRESS FIRMLY and PRINT clearly. Please fill in blanks, underline or circle the correct answers. Send top three copies to Kansas Department of Health and Environment, Bureau of Water, Topeka, Kansas 66620-0001. Telephone: 913-296-5545. Send one to WATER WELL OWNER and retain one for your records.

000187