WATER WELL RECORD Form WWC-5 KSA 82a-1212 ID No. _____

1 LOCATION OF WATER WELL: County: Gray | Fraction: NW ¼ SW ¼ SW ¼ | Section Number: 17 | Township Number: T 29 S | Range Number: R 30 E (W)

Distance and direction from nearest town or city street address of well if located within city?
1 Mile South of Copeland

2 WATER WELL OWNER: Spanier Inc.
RR#, St. Address, Box # : Ronald Spanier
City, State, ZIP Code : 31905 2 Road, Copeland, Kansas 67837
Board of Agriculture, Division of Water Resources Application Number: 14423

3 LOCATE WELL'S LOCATION WITH AN "X" IN SECTION BOX:

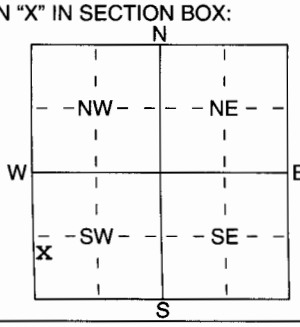

4 DEPTH OF COMPLETED WELL 375 ft. ELEVATION:
Depth(s) Groundwater Encountered 1 255 ft. 2 320 344 ft. 3 360 ft.
WELL'S STATIC WATER LEVEL 252 ft. below land surface measured on mo/day/yr 5-3-05
Pump test data: Well water was ft. after hours pumping gpm
Est. Yield 1000 gpm: Well water was ft. after hours pumping gpm
WELL WATER TO BE USED AS: 1 Domestic 2 Irrigation 3 Feedlot 4 Industrial 5 Public water supply 6 Oil field water supply 7 Domestic (lawn & garden) 8 Air conditioning 9 Dewatering 10 Monitoring well 11 Injection well 12 Other (Specify below)

Was a chemical/bacteriological sample submitted to Department? Yes ..... No X; If yes, mo/day/yrs sample was submitted
Water Well Disinfected? Yes X No

5 TYPE OF BLANK CASING USED: 1 Steel 2 PVC 3 RMP (SR) 4 ABS 5 Wrought iron 6 Asbestos-Cement 7 Fiberglass 8 Concrete tile 9 Other (specify below)
CASING JOINTS: Glued X & Clamped Welded Threaded

Blank casing diameter 16 315 in. to ft., Dia in. to ft., Dia in. to ft.
Casing height above land surface 12 in., weight lbs./ft. Wall thickness or guage No. SDR26

TYPE OF SCREEN OR PERFORATION MATERIAL: 1 Steel ~~2 Brass~~ 3 Stainless Steel 4 Galvanized Steel 5 Fiberglass 6 Concrete tile 7 PVC 8 RMP (SR) 9 ABS 10 Asbestos-Cement 11 Other (Specify) 12 None used (open hole)

SCREEN OR PERFORATION OPENINGS ARE: 1 Continuous slot 2 Louvered shutter 3 Mill slot 4 Key punched 5 Guazed wrapped 6 Wire wrapped 7 Torch cut 8 Saw cut 9 Drilled holes 10 Other (specify) 11 None (open hole)

SCREEN-PERFORATED INTERVALS: From 375-355 Agri ft. to ft., From 355-315 PVC ft. to ft.
From ft. to ft., From ft. to ft.
GRAVEL PACK INTERVALS: From 20 ft. to 375 ft., From ft. to ft.
From ft. to ft., From ft. to ft.

6 GROUT MATERIAL: 1 Neat cement 2 Cement grout 3 Bentonite 4 Other
Grout Intervals: From 0 ft. to 20 ft., From ft. to ft., From ft. to ft.

What is the nearest source of possible contamination:
1 Septic tank 2 Sewer lines 3 Watertight sewer lines 4 Lateral lines 5 Cess pool 6 Seepage pit 7 Pit privy 8 Sewage lagoon 9 Feedyard 10 Livestock pens 11 Fuel storage 12 Fertilizer storage 13 Insecticide storage 14 Abandoned water well 15 Oil well/Gas well 16 Other (specify below)
Direction from well? How many feet?

FROM	TO	LITHOLOGIC LOG	FROM	TO	PLUGGING INTERVALS
0	15	Topsoil & clay	253	255	Clay
15	41	Clay	255	316	Sand
41	43	Lime & clay	316	317	Cemented sand
43	45	Sand	317	318	Sand
45	60	Sand, cemented sand & clay	318	320	Clay
60	71	Sand & cemented sand	320	333	Sand
71	75	Clay & lime	333	335	Clay
75	105	Sand & cemented sand	335	343	Sand
105	150	Sand	343	344	Cemented sand
150	165	Sand & cemented sand	344	354	Sand & 1' Clay
165	195	Sand	354	357	Clay
195	210	Sand & cemented sand	357	360	Sand
210	240	Sand	360	371	Sand & cemented sand
240	253	Sand & 2' clay	371	375	Clay & lime

7 CONTRACTOR'S OR LANDOWNER'S CERTIFICATION: This water well was (1) constructed, (2) reconstructed, or (3) plugged under my jurisdiction and was completed on (mo/day/year) 5-3-05 and this record is true to the best of my knowledge and belief. Kansas Water Well Contractor's Licence No 223 This Water Well Record was completed on (mo/day/yr) 5-12-05
under the business name of Dunham Drilling Inc. by (signature) Kasie Dunham

INSTRUCTIONS: Use typewriter or ball point pen. *PLEASE PRESS FIRMLY* and *PRINT* clearly. Please fill in blanks, underline or circle the correct answers. Send top three copies to Kansas Department of Health and Environment, Bureau of Water, Geology Section, 1000 SW Jackson St., Suite 420, Topeka, Kansas 66612-1367. Telephone 785-296-5522. Send one to WATER WELL OWNER and retain one for your records. Fee of $5.00 for each constructed well.