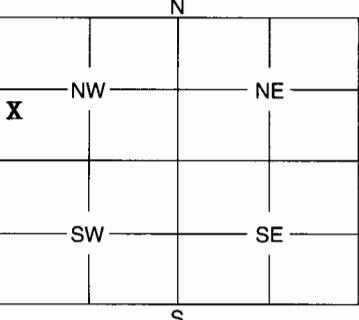


1	LOCATION OF WATER WELL: Gray County:	Fraction NW 1/4 SW 1/4 NW 1/4	Section Number 14	Township Number 29	Range Number 30
---	---	---	-----------------------------	------------------------------	---------------------------

Distance and direction from nearest town or city street address of well if located within city? **West side of Copeland, $\frac{1}{2}$ mile south, 4 miles east, 3,840 ft. north & 5,200 ft. west**

2	WATER WELL OWNER: Fry Family Farms c/o Ed Banning	RR #, St. Address, Box #: PO Box 1013 City, State, ZIP Code : Garden City, KS 67846	Board of Agriculture, Division of Water Resources Application Number: 20,886												
3	MARK WELL'S LOCATION WITH AN "X" IN SECTION BOX: 	4	DEPTH OF WELL 270 ft. WELL'S STATIC WATER LEVEL 204 ft. WELL WAS USED AS: <table border="0"> <tr> <td>1 Domestic</td> <td>5 Public Water Supply</td> <td>9 Dewatering</td> </tr> <tr> <td>2 Irrigation</td> <td>6 Oil Field Water Supply</td> <td>10 Monitoring Well</td> </tr> <tr> <td>3 Feedlot</td> <td>7 Domestic (Lawn & Garden)</td> <td>11 Injection Well</td> </tr> <tr> <td>4 Industrial</td> <td>8 Air Conditioning</td> <td>12 Other</td> </tr> </table> Was a chemical / bacteriological sample submitted to Department? Yes X No If yes, mo/day/yr sample was submitted Water Well Disinfected: Yes X No	1 Domestic	5 Public Water Supply	9 Dewatering	2 Irrigation	6 Oil Field Water Supply	10 Monitoring Well	3 Feedlot	7 Domestic (Lawn & Garden)	11 Injection Well	4 Industrial	8 Air Conditioning	12 Other
1 Domestic	5 Public Water Supply	9 Dewatering													
2 Irrigation	6 Oil Field Water Supply	10 Monitoring Well													
3 Feedlot	7 Domestic (Lawn & Garden)	11 Injection Well													
4 Industrial	8 Air Conditioning	12 Other													

5	TYPE OF BLANK CASING USED: <table border="0"> <tr> <td><input checked="" type="radio"/> 1 Steel</td> <td>3 RMP (SR)</td> <td>5 Wrought</td> <td>7 Fiberglass</td> <td>9 Other (Specify below)</td> </tr> <tr> <td>2 PVC</td> <td>4 ABS</td> <td>6 Asbestos-Cement</td> <td>8 Concrete Tile</td> <td>.....</td> </tr> </table> Blank casing diameter 16 in. Was casing pulled? Yes X No X If yes, how much Casing height above or below land surface 36 in. below	<input checked="" type="radio"/> 1 Steel	3 RMP (SR)	5 Wrought	7 Fiberglass	9 Other (Specify below)	2 PVC	4 ABS	6 Asbestos-Cement	8 Concrete Tile
<input checked="" type="radio"/> 1 Steel	3 RMP (SR)	5 Wrought	7 Fiberglass	9 Other (Specify below)							
2 PVC	4 ABS	6 Asbestos-Cement	8 Concrete Tile							

6	GROUT PLUG MATERIAL: 1 Neat cement <input checked="" type="radio"/> 2 Cement grout <input checked="" type="radio"/> 3 Bentonite 4 Other..... Grout Plug Intervals: From 8 ft. to 205 ft., From 3 ft. to 8 ft., From to ft.
---	---

What is the nearest source of possible contamination: <table border="0"> <tr> <td>1 Septic tank</td> <td>6 Seepage pit</td> <td>11 Fuel storage</td> <td>16 Other (specify below)</td> </tr> <tr> <td>2 Sewer lines</td> <td>7 Pit privy</td> <td>12 Fertilizer storage</td> <td>.....</td> </tr> <tr> <td>3 Watertight sewer lines</td> <td>8 Sewage lagoon</td> <td>13 Insecticide storage</td> <td>.....</td> </tr> <tr> <td>4 Lateral lines</td> <td>9 Feedyard</td> <td>14 Abandoned water well</td> <td>N/A</td> </tr> <tr> <td>5 Cess pool</td> <td>10 Livestock pens</td> <td>15 Oil well/Gas well</td> <td>.....</td> </tr> </table>	1 Septic tank	6 Seepage pit	11 Fuel storage	16 Other (specify below)	2 Sewer lines	7 Pit privy	12 Fertilizer storage	3 Watertight sewer lines	8 Sewage lagoon	13 Insecticide storage	4 Lateral lines	9 Feedyard	14 Abandoned water well	N/A	5 Cess pool	10 Livestock pens	15 Oil well/Gas well
1 Septic tank	6 Seepage pit	11 Fuel storage	16 Other (specify below)																	
2 Sewer lines	7 Pit privy	12 Fertilizer storage																	
3 Watertight sewer lines	8 Sewage lagoon	13 Insecticide storage																	
4 Lateral lines	9 Feedyard	14 Abandoned water well	N/A																	
5 Cess pool	10 Livestock pens	15 Oil well/Gas well																	

Direction from well? How many feet?		
FROM	TO	PLUGGING MATERIALS
0	3	Top soil
3	8	Bentonite
8	205	Cement Grout
205	270	Chlorinated Gravel

7	CONTRACTOR'S OF LANDOWNER'S CERTIFICATION: This water well was plugged under my jurisdiction and was completed on (mo/day/year) 3-24-08 and this record is true to the best of my knowledge and belief. Kansas Water Well Contractor's License No. 208 This Water Well Record was completed on (mo/day/year) 3-26-08 under the business name of Minter-Wilson Drilling Co., Inc. by (signature) Terri Miller
---	---

INSTRUCTIONS: Use typewriter or ball point pen. Please press firmly and print clearly. Please fill in blanks, underline or circle the correct answers. Send top three copies to Kansas Department of Health and Environment, Bureau of Water, Geology Section, 1000 SW Jackson St., Ste. 420, Topeka, Kansas 66612-1367. Telephone: 785/296-5522. Send one to Water Well Owner and retain one for your records.