

WATER WELL PLUGGING RECORD Form WWC-5P

KSA 82a-1212

ID NO.

00203946

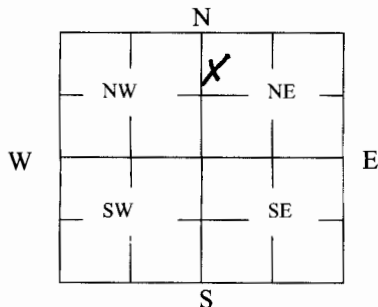
1 LOCATION OF WATER WELL: County: <u>Haskell</u>	Fraction <u>NW 1/4 NW 1/4 NE 1/4</u>	Section Number <u>32</u>	Township Number <u>29</u>	Range Number <u>32</u> E <u>W</u>
---	---	-----------------------------	------------------------------	--------------------------------------

Distance and direction from nearest town or city street address of well if located within city?

208 Hawes Ave.

2 WATER WELL OWNER: <u>City of Sublette</u> RR#, St. Address, Box #: <u>103 Cody St., P.O. Box 934</u> City, State ZIP Code: <u>Sublette, KS 67877</u>	Global Positioning Systems (decimal degrees, min. of 4 digits) Latitude: _____ Longitude: _____ Elevation: _____ Datum: _____ Data Collection Method: _____
--	--

3 MARK WELL'S LOCATION WITH AN "X" IN SECTION BOX:

4 DEPTH OF WELL 403 ft.WELL'S STATIC WATER LEVEL Unknown ft (Well caved in)

WELL WAS USED AS:

- | | | |
|--------------|------------------------------|-------------------|
| 1 Domestic | <u>5</u> Public Water Supply | 9 Dewatering |
| 2 Irrigation | 6 Oil Field Water Supply | 10 Monitoring |
| 3 Feedlot | 7 Domestic (Lawn & Garden) | 11 Injection Well |
| 4 Industrial | 8 Air Conditioning | 12 Other _____ |

Was a chemical/bacteriological sample submitted to Department? Yes _____ No _____

5 TYPE OF BLANK CASING USED:

- | | | | | |
|----------------|------------|-------------------|-----------------|-------------------------------|
| <u>1</u> Steel | 3 RMP (SR) | 5 Wrought | 7 Fiberglass | 9 Other (Specify below) _____ |
| 2 PVC | 4 ABS | 6 Asbestos-Cement | 8 Concrete Tile | |

Blank casing diameter 16 in. Was casing pulled? Yes _____ No ✓ If yes, how much _____

Casing height above or below land surface 12 in.

6 GROUT PLUG MATERIAL: 1 Neat cement 2 Cement grout 3 Bentonite 4 Other _____Grout Plug Intervals: From 0 ft. to 20 ft., From _____ ft. to _____ ft., From _____ to _____ ft.

What is the nearest source of possible contamination:

- | | | | |
|--------------------------|-------------------|-------------------------|----------------------------------|
| 1 Septic tank | 6 Seepage pit | 11 Fuel Storage | 16 Other (specify below) _____ |
| <u>2</u> Sewer lines | 7 Pit privy | 12 Fertilizer storage | |
| 3 Watertight sewer lines | 8 Sewage lagoon | 13 Insecticide storage | |
| 4 Lateral lines | 9 Feedyard | 14 Abandoned water well | Direction from well? <u>West</u> |
| 5 Cess pool | 10 Livestock pens | 15 Oil well/Gas well | How many feet? <u>310 ft.</u> |

FROM	TO	PLUGGING MATERIALS	FROM	TO	PLUGGING MATERIALS
<u>403 ft.</u>	<u>283 ft.</u>	<u>Well Caved in</u>			
<u>283 ft.</u>	<u>20 ft.</u>	<u>1/4" pea gravel</u>			
<u>20 ft.</u>	<u>0 ft.</u>	<u>Cement</u>			

7 CONTRACTOR'S OR LANDOWNER'S CERTIFICATION: This water well was plugged under my jurisdiction and was completed on (mo/day/year) 3/15/2012 and this record is true to the best of my knowledge and belief. Kansas Water Well Contractor's License No. _____. This Water Well Record was completed on (mo/day/year) 3/15/2012 under the business name of City of Sublette by (signature) [Signature]

INSTRUCTIONS: Use typewriter or ballpoint pen. Please press firmly and print clearly. Please fill in blanks, underline or circle the correct answers. Send top three copies to Kansas Department of Health and Environment, Bureau of Water, Geology Section, 1000 SW Jackson St., Ste. 420, Topeka, Kansas 66612-1367. Telephone: 785/296-5522. Send one to Water Well Owner and retain one for your records. Visit us at <http://www.kdheks.gov/geo/waterwells>.



COPY

City of Sublette <cityofsublette@gmail.com>

RE: Emailing: 001, 002, 003, 004

1 message

Richard Harper <rharper@kdheks.gov>

Mon, Nov 14, 2011 at 3:47 PM

To: City of Sublette <cityofsublette@gmail.com>, Allen R Nichols <ARNichols@kdheks.gov>

Mr. Rinehart,

Your proposal to plug the water well by not cutting the casing off three feet below grade is hereby approved. Please submit a copy of this e-mail and attach it to the Water Well Record (WWC-5 Form) that is required after the well is plugged.

Richard Harper

From: City of Sublette [mailto:cityofsublette@gmail.com]

Sent: Monday, November 14, 2011 3:24 PM

To: Allen R Nichols; Richard Harper

Subject: Fwd: Emailing: 001, 002, 003, 004

Dear Mr. Nichols and Mr. Harper:

The City of Sublette would like permission from you, stating that

it is ok for the City of Sublette to plug the old Cain Well that caved

in.

Refer to pictures.

Our plan is to break out the concrete pedestal around the casing

down to be flush with the slab, then cut off the casing and column pipe, then fill the casing and column pipe with concrete.

Sincerely,

Stanley Rinehart

City Superintendent