

CORRECTION(S) TO WATER WELL RECORD (WWC-5)

(to rectify lacking or incorrect information)

Location listed as:

Section-Township-Range: 36-29-35WFraction ($\frac{1}{4}$ $\frac{1}{4}$ $\frac{1}{4}$): _____County: Haskell

Location changed to:

36-29-32WSW SW SE

Other changes: Initial statements: _____

Changed to: _____

Comments: _____

verification method: KGS County Checker, KS Rural Directory Haskell/Grant Counties,
Aerial Photography for Haskell County.initials: DLdate: 7/24/2008

submitted by: Kansas Geological Survey, Data Resources Library, 1930 Constant Ave., Lawrence, KS 66047-3726

to: Kansas Dept of Health & Environment, Bureau of Water, 1000 SW Jackson, Suite 420, Topeka, KS 66612-1367.

1 LOCATION OF WATER WELL:	Fraction	Section Number	Township Number	Range Number
County: <u>Haskell</u>	<u>SW</u> $\frac{1}{4}$ <u>SW</u> $\frac{1}{4}$ <u>SE</u> $\frac{1}{4}$	<u>36</u>	<u>T</u> <u>29</u> <u>S</u>	<u>R</u> <u>35</u> <u>E(W)</u>

Distance and direction from nearest town or city street address of well if located within city?

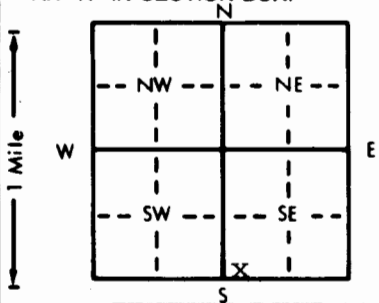
2 WATER WELL OWNER: Mrs. Floyd BurgessRR#, St. Address, Box # : Rt. #1

Board of Agriculture, Division of Water Resources

City, State, ZIP Code : Sublette, Ks. 67877

Application Number:

3 LOCATE WELL'S LOCATION WITH AN "X" IN SECTION BOX:

4 DEPTH OF COMPLETED WELL: 376 ft. ELEVATION:

Depth(s) Groundwater Encountered 1. ft. 2. ft. 3. ft.

WELL'S STATIC WATER LEVEL 260 ft. below land surface measured on mo/day/yr 8-22-94

Pump test data: Well water was ft. after hours pumping gpm

Est. Yield 40 gpm: Well water was ft. after hours pumping gpmBore Hole Diameter .. 10 in. to 376 ft., and in. to ft.

WELL WATER TO BE USED AS: 5 Public water supply 8 Air conditioning 11 Injection well

☒ Domestic 3 Feedlot 6 Oil field water supply 9 Dewatering 12 Other (Specify below)

2 Irrigation 4 Industrial 7 Lawn and garden only 10 Monitoring well

Was a chemical/bacteriological sample submitted to Department? Yes.....No...☒...; If yes, mo/day/yr sample was submittedWater Well Disinfected? Yes ☒ No

5 TYPE OF BLANK CASING USED:

1 Steel

3 RMP (SR)

5 Wrought iron

8 Concrete tile

CASING JOINTS: Glued ☒ Clamped☒ PVC

4 ABS

6 Asbestos-Cement

9 Other (specify below)

Welded

7 Fiberglass

Threaded

Blank casing diameter 5 in. to 376 ft., Dia in. to ft., Dia in. to ft.Casing height above land surface 12 in., weight lbs./ft. Wall thickness or gauge No. 200 psi

TYPE OF SCREEN OR PERFORATION MATERIAL:

1 Steel

3 Stainless steel

5 Fiberglass

☒ PVC

10 Asbestos-cement

2 Brass

4 Galvanized steel

6 Concrete tile

8 RMP (SR)

11 Other (specify)

9 ABS

12 None used (open hole)

SCREEN OR PERFORATION OPENINGS ARE:

1 Continuous slot

3 Mill slot

5 Gauzed wrapped

☒ Saw cut

11 None (open hole)

2 Louvered shutter

4 Key punched

6 Wire wrapped

9 Drilled holes

2 Louvered shutter

4 Key punched

7 Torch cut

10 Other (specify)

SCREEN-PERFORATED INTERVALS: From 316 ft. to 376 ft., From ft. to ft.

From ft. to ft., From ft. to ft.

GRAVEL PACK INTERVALS: From 25 ft. to 376 ft., From ft. to ft.

From ft. to ft., From ft. to ft.

6 GROUT MATERIAL:

1 Neat cement

2 Cement grout

☒ Bentonite

4 Other

Grout intervals: From 5 ft. to 25 ft., From ft. to ft., From ft. to ft.

What is the nearest source of possible contamination:

☒ Septic tank

4 Lateral lines

7 Pit privy

10 Livestock pens

14 Abandoned water well

2 Sewer lines

5 Cess pool

8 Sewage lagoon

11 Fuel storage

15 Oil well/Gas well

3 Watertight sewer lines

6 Seepage pit

9 Feedyard

12 Fertilizer storage

16 Other (specify below)

13 Insecticide storage

Direction from well?

How many feet? 100

FROM	TO	LITHOLOGIC LOG	FROM	TO	PLUGGING INTERVALS
0	1	top soil			
1	58	brown sandy clay			
58	62	fine to medium sand			
62	64	brown clay			
64	71	medium to coarse sand & gravel			
71	102	brown clay			
102	130	medium to coarse sand & gravel			
130	141	brown clay			
141	288	medium to coarse sand & gravel			
288	304	brown sandy clay			
304	306	blue clay			
306	343	fine to medium sand, coarse sand & gravel			
343	360	blue clay			
360	374	medium to coarse sand & gravel			
374	376	brown clay			

7 CONTRACTOR'S OR LANDOWNER'S CERTIFICATION: This water well was (☒ constructed, (2) reconstructed, or (3) plugged under my jurisdiction and was completed on (mo/day/year) 8-22-94 and this record is true to the best of my knowledge and belief. KansasWater Well Contractor's License No. 532 This Water Well Record was completed on (mo/day/yr) 8-25-94

under the business name of

Midwest Well & Pump

by (signature)

Victor Sankup

INSTRUCTIONS: Use typewriter or ball point pen. PLEASE PRESS FIRMLY and PRINT clearly. Please fill in blanks, underline or circle the correct answers. Send top three copies to Kansas Department of Health and Environment, Bureau of Water, Topeka, Kansas 66620-0001. Telephone: 913-296-5545. Send one to WATER WELL OWNER and retain one for your records.