

WATER WELL RECORD Form WWC-5 1253300


Original Record Correction Change in Well Use

Division of Water Resources App. No.

Well ID

1 LOCATION OF WATER WELL: County, Fraction, Section Number, Township Number, Range Number

2 WELL OWNER: Last Name, Business, Address, City, State, ZIP, Street or Rural Address

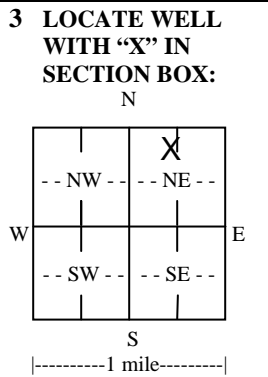

4 DEPTH OF COMPLETED WELL: Depth(s) Groundwater Encountered, WELL'S STATIC WATER LEVEL, Pump test data, Estimated Yield, Bore Hole Diameter

5 Latitude, Longitude, Datum, Source for Latitude/Longitude, 6 Elevation, Source

7 WELL WATER TO BE USED AS: Domestic, Irrigation, Industrial, Public Water Supply, Dewatering, Aquifer Recharge, Monitoring, Environmental Remediation, Oil Field Water Supply, Test Hole, Geothermal

Was a chemical/bacteriological sample submitted to KDHE? Water well disinfected?

8 TYPE OF CASING USED: Steel, PVC, Other, CASING JOINTS, Casing diameter, Casing height, TYPE OF SCREEN OR PERFORATION MATERIAL, SCREEN OR PERFORATION OPENINGS ARE, SCREEN-PERFORATED INTERVALS, GRAVEL PACK INTERVALS

9 GROUT MATERIAL: Neat cement, Cement grout, Bentonite, Other, Grout Intervals, Nearest source of possible contamination: Septic Tank, Sewer Lines, Watertight Sewer Lines, Lateral Lines, Cess Pool, Seepage Pit, Pit Privy, Sewage Lagoon, Feedyard, Livestock Pens, Fuel Storage, Fertilizer Storage, Insecticide Storage, Abandoned Water Well, Oil Well/Gas Well

10 FROM TO LITHOLOGIC LOG FROM TO LITHO. LOG (cont.) or PLUGGING INTERVALS

11 CONTRACTOR'S OR LANDOWNER'S CERTIFICATION: This water well was constructed, reconstructed, or plugged under my jurisdiction and was completed on (mo-day-year) and this record is true to the best of my knowledge and belief.

Form	WWC5
Contractor	Hydro Resources Mid Continent, Inc.
Well Owner	Gerald Stoppel
Doc ID	1253300

Litholgy

From	To	LithologicLog
0	2	top soil
2	39	brown sandy clay
39	59	brown sandy clay w/ some fine sand beds
59	67	fine sand
67	74	sand fine to med coarse w/ couple clay ledges
74	180	sand fine to med coarse small some med gravel
180	288	sand fine to med coarse small gravel
288	300	brown sandy clay
300	373	blue clay
373	392	fine sand
392	400	sand fine to med coarse
400	421	brown sandy clay w/ few sand strips
421	440	sand fine to med
440	449	brown sandy clay w/ some sand strips
449	458	brown clay -sticky-
458	471	fine sand w/ some clay stringers
471	503	brown sandy clay
503	539	fine sand w/ few clay stringers
539	566	brown sandy clay -sticky-

Form	WWC5
Contractor	Hydro Resources Mid Continent, Inc.
Well Owner	Gerald Stoppel
Doc ID	1253300

Litholgy

From	To	LithologicLog
566	572	brown rock
572	643	shale
643	657	shale w/ some sandstone strips
657	689	shale
689	721	sandstone & shale
721	740	red bed