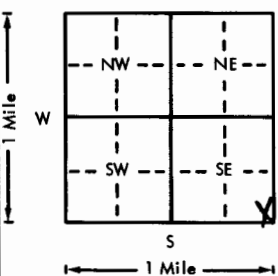
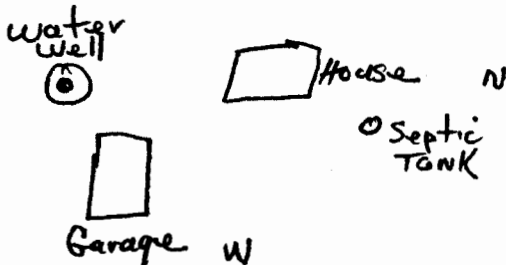


USE TYPEWRITER OR BALL
POINT PEN-PRESS FIRMLY,
PRINT CLEARLY.

WATER WELL RECORD
KSA 82a-1201-1215

Kansas Department of Health and
Environment-Division of Environment
(Water well Contractors)
Topeka, Kansas 66620

1. Location of well:		County <u>Haskell</u>	Fraction <u>SE 1/4 SE 1/4 SE 1/4</u>	Section number <u>NE 3</u>	Township number <u>T 29 S</u>	Range number <u>R 34 E/W</u>
2. Distance and direction from nearest town or city: <u>9 Mi. North</u>		3. Owner of well: <u>Melvin Simpson</u>				
Street address of well location if in city: <u>Satanta, Kansas</u>		R.R. or street: <u>Rt. #1</u>				
		City, state, zip code: <u>Satanta, Ks.</u>				
4. Locate with "X" in section below:		Sketch map:		6. Bore hole dia. <u>9 7/8</u> in. Completion date <u>4-25-77</u>		
				Well depth <u>510</u> ft.		
5. Type and color of material		From	To	7. <input checked="" type="checkbox"/> Cable tool <input checked="" type="checkbox"/> Rotary <input type="checkbox"/> Driven <input type="checkbox"/> Dug		
<u>Surface: Brown Clay</u>		<u>0</u>	<u>20</u>	<input type="checkbox"/> Hollow rod <input type="checkbox"/> Jetted <input type="checkbox"/> Bored <input type="checkbox"/> Reverse rotary		
<u>Broken Clay</u>		<u>20</u>	<u>60</u>	8. Use: <input checked="" type="checkbox"/> Domestic <input checked="" type="checkbox"/> Public supply <input type="checkbox"/> Industry		
<u>Coarse Sand</u>		<u>60</u>	<u>175</u>	<input type="checkbox"/> Irrigation <input type="checkbox"/> Air conditioning <input type="checkbox"/> Stock		
<u>Brown Clay</u>		<u>175</u>	<u>340</u>	<input type="checkbox"/> Lawn <input type="checkbox"/> Oil field water <input type="checkbox"/> Other		
<u>Blue clay</u>		<u>340</u>	<u>375</u>	9. Casing: Material <u>Styro</u> Height: Above or below		
<u>Coarse sand</u>		<u>375</u>	<u>420</u>	Threaded <input type="checkbox"/> Welded <input checked="" type="checkbox"/> Surface <u>1 1/2</u> in.		
<u>Brown Clay: gyp</u>		<u>420</u>	<u>460</u>	RMP <input type="checkbox"/> PVC <input type="checkbox"/> Weight <input type="checkbox"/> lbs./ft.		
<u>Coarse sand</u>		<u>460</u>	<u>510</u>	Dia. <u>5</u> in. to <u>510</u> ft. depth Wall Thickness: inches or		
				Dia. <input type="checkbox"/> in. to <input type="checkbox"/> ft. depth Gage No. <u>0.320</u>		
				10. Screen: Manufacturer's name <u>Sanflow</u>		
				Plastic pipe Co. <u>Plastic pipe Co.</u>		
				Type <u>Styro</u> Dia. <u>5</u>		
				Slot/gauze <u>26 (1/16)</u> Length <u>60</u>		
				Set between <u>450</u> ft. and <u>510</u> ft.		
				<input type="checkbox"/> ft. and <input type="checkbox"/> ft.		
				Gravel pack? <input checked="" type="checkbox"/> Size range of material <u>4x16</u>		
				11. Static water level: <u>290</u> ft. below land surface Date <u>4-20-77</u>		
				12. Pumping level below land surfaces: <u>N.A.</u>		
				<input type="checkbox"/> ft. after <input type="checkbox"/> hrs. pumping <input type="checkbox"/> g.p.m.		
				<input type="checkbox"/> ft. after <input type="checkbox"/> hrs. pumping <input type="checkbox"/> g.p.m.		
				Estimated maximum yield <input type="checkbox"/> g.p.m.		
				13. Water sample submitted: <u>N.A.</u> mo./day/yr.		
				Yes <input type="checkbox"/> No <input type="checkbox"/> Date <input type="checkbox"/>		
				14. Well head completion:		
				<input checked="" type="checkbox"/> Pitless adapter <u>16</u> inches above grade		
				15. Well grouted? <input checked="" type="checkbox"/>		
				With: <input type="checkbox"/> Neat cement <input checked="" type="checkbox"/> Bentonite <input type="checkbox"/> Concrete		
				Depth: From <u>8</u> ft. to <u>20</u> ft.		
				16. Nearest source of possible contamination: <u>Septic</u>		
				ft. <u>200</u> Direction <u>SE</u> Type <u>TANK</u>		
				Well disinfected upon completion? <input checked="" type="checkbox"/> Yes <input type="checkbox"/> No		
				17. Pump: <input type="checkbox"/> Not installed		
				Manufacturer's name <u>Goulds</u>		
				Model number <u>NA</u> HP <u>3</u> Volts <u>230</u>		
				Length of drop pipe <u>383</u> ft. capacity <u>16</u> g.p.m.		
				Type:		
				<input checked="" type="checkbox"/> Submersible <input type="checkbox"/> Turbine		
				<input type="checkbox"/> Jet <input type="checkbox"/> Reciprocating		
				<input type="checkbox"/> Centrifugal <input type="checkbox"/> Other		
18. Elevation: <u>Flat</u>		19. Remarks: <u>Concrete slab to be installed by customer at surface of ground.</u>		20. Water well contractor's certification: This well was drilled under my jurisdiction and this report is true to the best of my knowledge and belief. <u>Wagner Drilling</u> <u>253</u> Business name License No. Address <u>Wesley, Ks.</u> Signed <u>Wagner Wagner</u> Date <u>4-30-77</u> Authorized representative		

Forward the white, blue and pink copies to the Department of Health and Environment

Form WWC-5