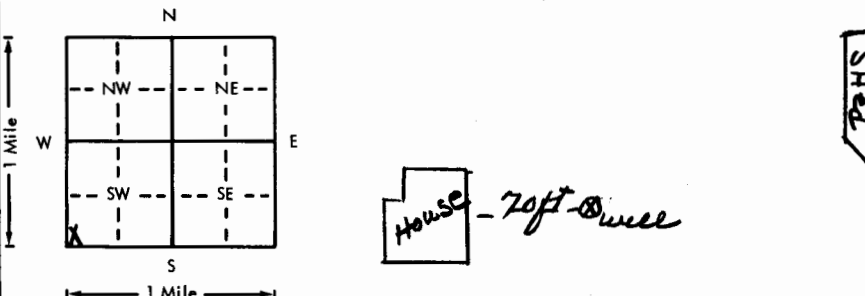


USE TYPEWRITER OR BALL POINT PEN-PRESS FIRMLY, PRINT CLEARLY.

WATER WELL RECORD  
KSA 82a-1201-1215

Kansas Department of Health and Environment-Division of Environment  
(Water well Contractors)  
Topeka, Kansas 66620

1. Location of well:	County <b>Haskell</b>	Fraction <b>SW 1/4 SW 1/4 SW 1/4</b>	Section number <b>7</b>	Township number <b>T 29 S R 34</b>	Range number <b>34</b>	<b>E/W</b>
2. Distance and direction from nearest town or city: Street address of well location if in city: <b>Satanta, Ks.</b>			3. Owner of well: R.R. or street: <b>Howard Pickens</b> City, state, zip code: <b>Satanta, Ks. 67870</b>			
4. Locate with "X" in section below: Sketch map: 			6. Bore hole dia. <u>9 1/4</u> in. Completion date _____ Well depth <u>515</u> ft. <u>10-20-77</u>			
5. Type and color of material			7. <input type="checkbox"/> Cable tool <input checked="" type="checkbox"/> Rotary <input type="checkbox"/> Driven <input type="checkbox"/> Dug <input type="checkbox"/> Hollow rod <input type="checkbox"/> Jetted <input type="checkbox"/> Bored <input type="checkbox"/> Reverse rotary			
			8. Use: <input checked="" type="checkbox"/> Domestic <input type="checkbox"/> Public supply <input type="checkbox"/> Industry <input type="checkbox"/> Irrigation <input type="checkbox"/> Air conditioning <input type="checkbox"/> Stock <input type="checkbox"/> Lawn <input type="checkbox"/> Oil field water <input type="checkbox"/> Other			
			9. Casing: Material <u>styrene</u> Height: Above or below Threaded <input type="checkbox"/> Welded <input type="checkbox"/> Surface <u>18</u> in. RMP <u>PVC</u> <u>glued</u> Weight _____ lbs./ft. Dia. <u>5</u> in. to <u>395</u> ft. depth Wall Thickness: inches or Dia. _____ in. to _____ ft. depth gage No. <u>320</u>			
			10. Screen: Manufacturer's name <u>Sunflower</u> Type <u>styrene</u> Dia. <u>10 1/2</u> / <u>5'</u> Slot/gauze <u>1/16</u> Length <u>120'</u> Set between <u>395</u> ft. and <u>515</u> ft. _____ ft. and _____ ft. Gravel pack? <input checked="" type="checkbox"/> Size range of material <u>1/4"</u>			
			11. Static water level: _____ mo./day/yr. <u>245</u> ft. below land surface Date <u>10-20-77</u>			
			12. Pumping level below land surfaces: <u>NA</u> _____ ft. after _____ hrs. pumping _____ g.p.m. _____ ft. after _____ hrs. pumping _____ g.p.m. Estimated maximum yield _____ g.p.m.			
			13. Water sample submitted: _____ mo./day/yr. Yes <input checked="" type="checkbox"/> No <input type="checkbox"/> Date _____			
			14. Well head completion: <input checked="" type="checkbox"/> Pitless adapter <u>18</u> inches above grade			
			15. Well grouted? <input checked="" type="checkbox"/> With: <input checked="" type="checkbox"/> Neat cement <input type="checkbox"/> Bentonite <input type="checkbox"/> Concrete Depth: From <u>0</u> ft. to <u>10</u> ft.			
			16. Nearest source of possible contamination: ft. <u>250</u> Direction <u>south</u> Type <u>sewer line</u> Well disinfected upon completion? <input checked="" type="checkbox"/> Yes <input type="checkbox"/> No			
			17. Pump: <input checked="" type="checkbox"/> Not installed Manufacturer's name _____ Model number _____ HP _____ Volts _____ Length of drop pipe _____ ft. capacity _____ g.p.m. Type: <input type="checkbox"/> Submersible <input type="checkbox"/> Turbine <input type="checkbox"/> Jet <input type="checkbox"/> Reciprocating <input type="checkbox"/> Centrifugal <input type="checkbox"/> Other			
18. Elevation:			19. Remarks: <u>(12) Farmer set his own pump</u>			
Topography: <input type="checkbox"/> Hill <input checked="" type="checkbox"/> Slope <input type="checkbox"/> Upland <input type="checkbox"/> Valley			20. Water well contractor's certification: This well was drilled under my jurisdiction and this report is true to the best of my knowledge and belief. <u>Houck Bros. Drilling Co. 164</u> Business name License No. _____ Address <u>Box 487, Ulysses, Ks.</u> Signed <u>M. Beard</u> Date <u>12/27/77</u> Authorized representative			

29 34 E  
R  
1/4 1/4 1/4  
Sec