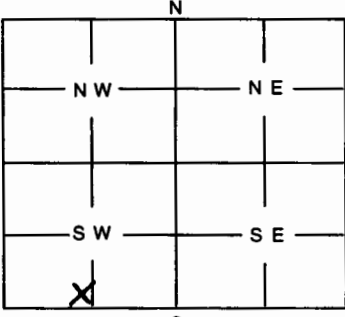


#5

1	LOCATION OF WATER WELL: County: <u>Haskell</u>	Section Number <u>28</u>	Township Number <u>29</u>	Range Number <u>34</u>																								
Distance and direction from nearest town or city street address of well if located within city? <u>3 Miles North and 3 Miles West of Satanta</u>																												
2	WATER WELL OWNER: <u>Steve Hall</u> <u>c/o Kirby Clawson</u> RR #, St. Address, Box #: <u>Box 65F</u> City, State, ZIP Code: <u>Satanta, KS 67870</u>																											
3 MARK WELL'S LOCATION WITH AN "X" IN SECTION BOX: <div style="text-align: center;">  </div>		4 DEPTH OF WELL <u>253</u> ft. WELL'S STATIC WATER LEVEL <u>Dry</u> ft. WELL WAS USED AS: <table style="width: 100%;"> <tr> <td><input checked="" type="checkbox"/> 1 Domestic</td> <td>5 Public Water Supply</td> <td>9 Dewatering</td> </tr> <tr> <td>2 Irrigation</td> <td>6 Oil Field Water Supply</td> <td>10 Monitoring Well</td> </tr> <tr> <td>3 Feedlot</td> <td>7 Domestic (Lawn & Garden)</td> <td>11 Injection Well</td> </tr> <tr> <td>4 Industrial</td> <td>8 Air Conditioning</td> <td>12 Other</td> </tr> </table> Was a chemical / bacteriological sample submitted to Department? Yes No <input checked="" type="checkbox"/> If yes, mo/day/yr sample was submitted Water Well Disinfected: Yes No			<input checked="" type="checkbox"/> 1 Domestic	5 Public Water Supply	9 Dewatering	2 Irrigation	6 Oil Field Water Supply	10 Monitoring Well	3 Feedlot	7 Domestic (Lawn & Garden)	11 Injection Well	4 Industrial	8 Air Conditioning	12 Other												
<input checked="" type="checkbox"/> 1 Domestic	5 Public Water Supply	9 Dewatering																										
2 Irrigation	6 Oil Field Water Supply	10 Monitoring Well																										
3 Feedlot	7 Domestic (Lawn & Garden)	11 Injection Well																										
4 Industrial	8 Air Conditioning	12 Other																										
5	TYPE OF BLANK CASING USED: <input checked="" type="checkbox"/> 1 Steel 3 RMP (SR) 5 Wrought 7 Fiberglass 9 Other (Specify below) 2 PVC 4 ABS 6 Asbestos-Cement 8 Concrete Tile Blank casing diameter <u>5</u> in. Was casing pulled? Yes No <input checked="" type="checkbox"/> If yes, how much Casing height above or below land surface <u>60</u> in.																											
6	GROUT PLUG MATERIAL: 1 Neat cement 2 Cement grout <input checked="" type="checkbox"/> 3 Bentonite 4 Other Grout Plug Intervals: From ft. to ft., From ft. to ft., From ft. to ft. What is the nearest source of possible contamination: <table style="width: 100%;"> <tr> <td>1 Septic tank</td> <td>6 Seepage pit</td> <td>11 Fuel storage</td> <td>16 Other (specify below)</td> </tr> <tr> <td>2 Sewer lines</td> <td>7 Pit privy</td> <td>12 Fertilizer storage</td> <td></td> </tr> <tr> <td>3 Watertight sewer lines</td> <td>8 Sewage lagoon</td> <td>13 Insecticide storage</td> <td></td> </tr> <tr> <td>4 Lateral lines</td> <td>9 Feedyard</td> <td><input checked="" type="checkbox"/> 14 Abandoned water well</td> <td></td> </tr> <tr> <td>5 Cess Pool</td> <td>10 Livestock pens</td> <td>15 Oil well/Gas well</td> <td></td> </tr> </table> Direction from well? <u>Northwest</u> How many feet? <u>500</u>				1 Septic tank	6 Seepage pit	11 Fuel storage	16 Other (specify below)	2 Sewer lines	7 Pit privy	12 Fertilizer storage		3 Watertight sewer lines	8 Sewage lagoon	13 Insecticide storage		4 Lateral lines	9 Feedyard	<input checked="" type="checkbox"/> 14 Abandoned water well		5 Cess Pool	10 Livestock pens	15 Oil well/Gas well					
1 Septic tank	6 Seepage pit	11 Fuel storage	16 Other (specify below)																									
2 Sewer lines	7 Pit privy	12 Fertilizer storage																										
3 Watertight sewer lines	8 Sewage lagoon	13 Insecticide storage																										
4 Lateral lines	9 Feedyard	<input checked="" type="checkbox"/> 14 Abandoned water well																										
5 Cess Pool	10 Livestock pens	15 Oil well/Gas well																										
<table border="1" style="width: 100%; border-collapse: collapse;"> <thead> <tr> <th style="width: 15%;">FROM</th> <th style="width: 15%;">TO</th> <th style="width: 70%;">PLUGGING MATERIALS</th> </tr> </thead> <tbody> <tr> <td><u>253</u></td> <td><u>10</u></td> <td><u>Clay/Subsoil</u></td> </tr> <tr> <td><u>10</u></td> <td><u>5</u></td> <td><u>Bentonite</u></td> </tr> <tr> <td><u>5</u></td> <td><u>-</u></td> <td><u>Cut-off Casing & Backfill</u></td> </tr> <tr><td> </td><td> </td><td> </td></tr> <tr><td> </td><td> </td><td> </td></tr> <tr><td> </td><td> </td><td> </td></tr> <tr><td> </td><td> </td><td> </td></tr> </tbody> </table>					FROM	TO	PLUGGING MATERIALS	<u>253</u>	<u>10</u>	<u>Clay/Subsoil</u>	<u>10</u>	<u>5</u>	<u>Bentonite</u>	<u>5</u>	<u>-</u>	<u>Cut-off Casing & Backfill</u>												
FROM	TO	PLUGGING MATERIALS																										
<u>253</u>	<u>10</u>	<u>Clay/Subsoil</u>																										
<u>10</u>	<u>5</u>	<u>Bentonite</u>																										
<u>5</u>	<u>-</u>	<u>Cut-off Casing & Backfill</u>																										
7	CONTRACTOR'S OR LANDOWNER'S CERTIFICATION: This water well was plugged under my jurisdiction and was completed on (mo/day/year) <u>12-12-01</u> and this record is true to the best of my knowledge and belief. Kansas Water Well Contractor's License No. <u>12-12-01</u> under the business name of <u>Southwest Windmill</u> This Water Well Record was completed on (mo/day/year) <u>12-12-01</u> by (signature) <u>David Enns</u>																											

INSTRUCTIONS: Use typewriter or ball point pen. Please press firmly and print clearly. Please fill in blanks, underline or circle the correct answers. Send top three copies to Kansas Department of Health and Environment, Bureau of Water, Topeka, Kansas 66620-0001. Telephone: 785/296-3565. Send one to Water Well Owner and retain one for your records.