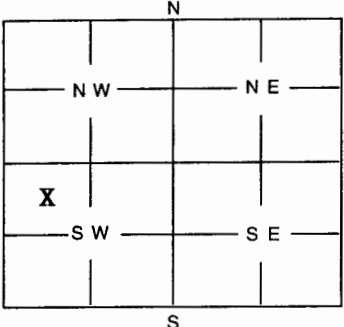


1	LOCATION OF WATER WELL:	Fraction	Section Number	Township Number	Range Number																								
	County: Haskell	NC 1/4 NW 1/4 SW 1/4	34	29	34 W																								
Distance and direction from nearest town or city street address of well if located within city? From Hwy. 56 on west side of Satanta 2-3/4 miles north, 1 mile west, 4,637 ft. west & approx 2,350 ft. north																													
2	WATER WELL OWNER: Pioneer Natural Resources Well #88-23 RR #, St. Address, Box #: PO Box 1006 Board of Agriculture, Division of Water Resources City, State, ZIP Code : Ulysses, Kansas 67880 Application Number:																												
3	MARK WELL'S LOCATION WITH AN "X" IN SECTION BOX: 																												
4	DEPTH OF WELL 405 ft. WELL'S STATIC WATER LEVEL 340 ft. WELL WAS USED AS: 1 Domestic 2 Irrigation 3 Feedlot 4 Industrial 5 Public Water Supply 6 Oil Field Water Supply 7 Domestic (Lawn & Garden) 8 Air Conditioning 9 Dewatering 10 Monitoring Well 11 Injection Well 12 Other Was a chemical / bacteriological sample submitted to Department? Yes No X If yes, mo/day/yr sample was submitted Water Well Disinfected: Yes No X																												
5	TYPE OF BLANK CASING USED: 1 Steel 2 PVC Blank casing diameter4..... in. 3 RMP (SR) 4 ABS Casing height above or below land surface36..... in. 5 Wrought 6 Asbestos-Cement Was casing pulled? Yes No X..... If yes, how much 7 Fiberglass 8 Concrete Tile 9 Other (Specify below)																												
6	GROUT PLUG MATERIAL: 1 Neat cement 2 Cement grout 3 Bentonite 4 Other Grout Plug Intervals: From 3 ft. to 405 ft., From ft. to ft., From to ft. What is the nearest source of possible contamination: 1 Septic tank 2 Sewer lines 3 Watertight sewer lines 4 Lateral lines 5 Cess Pool 6 Seepage pit 7 Pit privy 8 Sewage lagoon 9 Feedyard 10 Livestock pens 11 Fuel storage 12 Fertilizer storage 13 Insecticide storage 14 Abandoned water well 15 Oil well/Gas well 16 Other (specify below) Direction from well? How many feet?																												
<table border="1" style="width:100%; border-collapse: collapse;"> <thead> <tr> <th style="width:10%;">FROM</th> <th style="width:10%;">TO</th> <th style="width:80%;">PLUGGING MATERIALS</th> </tr> </thead> <tbody> <tr> <td>3</td> <td>405</td> <td>Cement Grout</td> </tr> <tr><td> </td><td> </td><td> </td></tr> <tr><td> </td><td> </td><td> </td></tr> <tr><td> </td><td> </td><td> </td></tr> <tr><td> </td><td> </td><td> </td></tr> <tr><td> </td><td> </td><td> </td></tr> <tr><td> </td><td> </td><td> </td></tr> </tbody> </table>						FROM	TO	PLUGGING MATERIALS	3	405	Cement Grout																		
FROM	TO	PLUGGING MATERIALS																											
3	405	Cement Grout																											
7	CONTRACTOR'S OR LANDOWNER'S CERTIFICATION: This water well was plugged under my jurisdiction and was completed on (mo/day/year) 11-13-09 and this record is true to the best of my knowledge and belief. Kansas Water Well Contractor's License No. 208 This Water Well Record was completed on (mo/day/year) 11-18-09 under the business name of Minter-Wilson Drilling Co., Inc. by (signature) <i>Dora Keller</i>																												
INSTRUCTIONS: Use typewriter or ball point pen. <u>Please press firmly and print clearly.</u> Please fill in blanks, underline or circle the correct answers. Send top three copies to Kansas Department of Health and Environment, Bureau of Water, Topeka, Kansas 66620-0001. Telephone: 785/296-3565. Send one to Water Well Owner and retain one for your records.																													