


1 LOCATION OF WATER WELL: Fraction Section Number Township Number Range Number  
 County: **Haskell** C 1/4 NW 1/4 NE 1/4 22 T 29 S R 34 EW

Distance and direction from nearest town or city street address of well if located within city?  
**3 Miles West, 5 Miles North, 1/4 mile West of Satana**

2 WATER WELL OWNER: **Ray Winsted** **Murfin Drilling, Inc.**  
 RR#, St. Address, Box #: **3010 Ribera Road** **Box 661** Board of Agriculture, Division of Water Resources  
 City, State, ZIP Code: **Carmel, CA 93923** **Colby, Ks. 67701** Application Number: **940428**

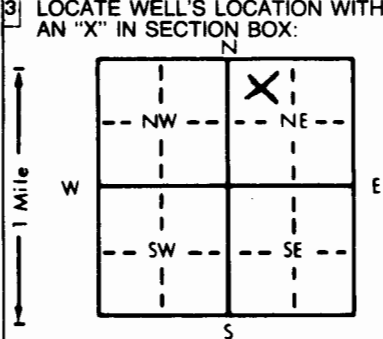

4 DEPTH OF COMPLETED WELL: **380** ft. ELEVATION:  
 Depth(s) Groundwater Encountered 1. .... ft. 2. .... ft. 3. .... ft.  
 WELL'S STATIC WATER LEVEL: **342** ft. below land surface measured on mo/day/yr  
 Pump test data: Well water was .... ft. after .... hours pumping .... gpm  
 Est. Yield .... gpm: Well water was .... ft. after .... hours pumping .... gpm  
 Bore Hole Diameter: **8** in. to **380** ft., and .... in. to .... ft.  
 WELL WATER TO BE USED AS:  
 5 Public water supply 8 Air conditioning 11 Injection well  
 1 Domestic 3 Feedlot 6 Oil field water supply 9 Dewatering 12 Other (Specify below)  
 2 Irrigation 4 Industrial 7 Lawn and garden only 10 Monitoring well  
 Was a chemical/bacteriological sample submitted to Department? Yes..... No. **X**.....; If yes, mo/day/yr sample was submitted  
 Water Well Disinfected? Yes No **X**

5 TYPE OF BLANK CASING USED:  
 1 Steel 3 RMP (SR) 5 Wrought iron 8 Concrete tile CASING JOINTS: Glued ..... Clamped .....  
 2 PVC 4 ABS 6 Asbestos-Cement 9 Other (specify below) Welded .....  
 7 Fiberglass Threaded. **X**  
 Blank casing diameter: **4.5** in. to **320** ft., Dia. .... in. to .... ft., Dia. .... in. to .... ft.  
 Casing height above land surface: **18** in., weight **2.38** lbs./ft. Wall thickness or gauge No. **248**  
 TYPE OF SCREEN OR PERFORATION MATERIAL:  
 1 Steel 3 Stainless steel 5 Fiberglass 7 PVC 10 Asbestos-cement  
 2 Brass 4 Galvanized steel 6 Concrete tile 8 RMP (SR) 11 Other (specify) .....  
 9 ABS 12 None used (open hole)  
 SCREEN OR PERFORATION OPENINGS ARE:  
 1 Continuous slot 3 Mill slot 5 Gauzed wrapped 8 Saw cut 11 None (open hole)  
 2 Louvered shutter 4 Key punched 6 Wire wrapped 9 Drilled holes  
 7 Torch cut 10 Other (specify) .....  
 SCREEN-PERFORATED INTERVALS: From **320** ft. to **380** ft., From ..... ft. to ..... ft.  
 GRAVEL PACK INTERVALS: From **20** ft. to **380** ft., From ..... ft. to ..... ft.

6 GROUT MATERIAL: 1 Neat cement 2 Cement grout 3 Bentonite 4 Other .....  
 Grout Intervals: From **0** ft. to **20** ft., From ..... ft. to ..... ft., From ..... ft. to ..... ft.  
 What is the nearest source of possible contamination:  
 1 Septic tank 4 Lateral lines 7 Pit privy 10 Livestock pens 14 Abandoned water well  
 2 Sewer lines 5 Cess pool 8 Sewage lagoon 11 Fuel storage 15 Oil well/Gas well  
 3 Watertight sewer lines 6 Seepage pit 9 Feedyard 12 Fertilizer storage 16 Other (specify below)  
 13 Insecticide storage  
 Direction from well? **North** How many feet? **100'**

FROM	TO	LITHOLOGIC LOG	FROM	TO	PLUGGING INTERVALS
0	2	Surface	189	224	Sticky Clay
2	20	Loess	224	235	Sandy Clay w/a few Fine Sand Strks.
20	38	Clay & Caliche			
38	52	Med. Sand & Gravel w/Rocks & Cemented Sand	235	246	Sticky Clay
			246	267	Sandy Clay w/a Few Sand Strks
52	64	Tight Med. Sand w/Rocks and Caliche Strks.	267	338	Med. Sand w/Clay Strks.
			338	339	Clay
64	87	Sticky Clay	339	340	Caliche
87	119	Med. Sand & Gravel	340	351	Med. Sand
119	120	Sandy Clay	351	354	Sandy Clay w/Sand Strks.
120	129	Sticky Clay w/Some Sand	354	380	Med. Sand & Gravel w/ a Few Clay Strks.
129	180	Med. Sand & Gravel w/few Clay Strks.			
180	189	Med. Sand & Gravel w/Rocks & a Few Clay Strks.			

7 CONTRACTOR'S OR LANDOWNER'S CERTIFICATION: This water well was (1) constructed, (2) reconstructed, or (3) plugged under my jurisdiction and was completed on (mo/day/year) **12-9-94** and this record is true to the best of my knowledge and belief. Kansas Water Well Contractor's License No. **554** This Water Well Record was completed on (mo/day/yr) **12-10-94** under the business name of **Woofter Pump & Well, Inc.** by (signature) *[Signature]*

INSTRUCTIONS: Use typewriter or ball point pen. PLEASE PRESS FIRMLY and PRINT clearly. Please fill in blanks, underline or circle the correct answers. Send top three copies to Kansas Department of Health and Environment, Bureau of Water, Topeka, Kansas 66620-0001. Telephone: 913-296-5545. Send one to WATER WELL OWNER and retain one for your records