


1 LOCATION OF WATER WELL: Fraction S 1/2 1/4 NE 1/4 SW 1/4 Section Number 35 Township Number T 29 S Range Number R 35 E W
 County: GRANT

Distance and direction from nearest town or city street address of well if located within city?
SOUTH OF RYUS TO CURVE 1 WEST 8/10 SOUTH, NORTHEAST INTO LOC.

2 WATER WELL OWNER: OXY U.S.A. #1 MLP Nicevander A
 RR#, St. Address, Box #: BOX 26100 Board of Agriculture, Division of Water Resources
 City, State, ZIP Code: OKLAHOMA CITY, OK 73126-0100 Application Number: (OXY permitted)

3 LOCATE WELL'S LOCATION WITH AN "X" IN SECTION BOX:

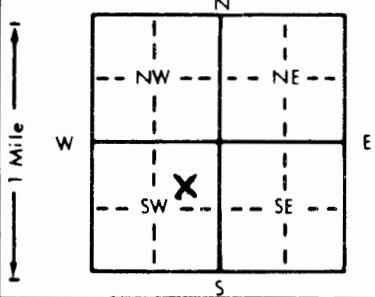

4 DEPTH OF COMPLETED WELL: 460 ft. ELEVATION: (OXY permitted)
 Depth(s) Groundwater Encountered: 1. 325 ft. 2. _____ ft. 3. _____ ft.
 WELL'S STATIC WATER LEVEL: 325 ft. below land surface measured on mo/day/yr 6-1-94
 Pump test data: Well water was 340 ft. after 1 hours pumping 140 gpm
 Est. Yield: 140 gpm; Well water was _____ ft. after _____ hours pumping _____ gpm
 Bore Hole Diameter: 11 in. to 460 ft., and _____ in. to _____ ft.
 WELL WATER TO BE USED AS:
 5 Public water supply 8 Air conditioning 11 Injection well
 1 Domestic 3 Feedlot 6 Oil field water supply 9 Dewatering 12 Other (Specify below)
 2 Irrigation 4 Industrial 7 Lawn and garden only 10 Monitoring well
 Was a chemical/bacteriological sample submitted to Department? Yes _____ No x; If yes, mo/day/yr sample was submitted _____
 Water Well Disinfected? Yes x No _____

5 TYPE OF BLANK CASING USED:
 1 Steel 3 RMP (SR) 5 Wrought iron 8 Concrete tile CASING JOINTS: Glued x Clamped _____
2 PVC 4 ABS 6 Asbestos-Cement 9 Other (specify below) Welded _____
 7 Fiberglass _____ Threaded _____

Blank casing diameter: 6 in. to 460 ft., Dia _____ in. to _____ ft., Dia _____ in. to _____ ft.
 Casing height above land surface: 24 in., weight 2.902 lbs./ft. Wall thickness or gauge No. .316 SDR 21

TYPE OF SCREEN OR PERFORATION MATERIAL:
 1 Steel 3 Stainless steel 5 Fiberglass 7 PVC 10 Asbestos-cement
 2 Brass 4 Galvanized steel 6 Concrete tile 8 RMP (SR) 11 Other (specify) _____
 9 ABS 12 None used (open hole)

SCREEN OR PERFORATION OPENINGS ARE:
 1 Continuous slot 3 Mill slot 5 Gauzed wrapped 8 Saw cut 11 None (open hole)
 2 Louvered shutter 4 Key punched 6 Wire wrapped 9 Drilled holes
 7 Torch cut 10 Other (specify) _____

SCREEN-PERFORATED INTERVALS: From 360 ft. to 460 ft. From _____ ft. to _____ ft.
 From _____ ft. to _____ ft. From _____ ft. to _____ ft.
 GRAVEL PACK INTERVALS: From 260 ft. to 460 ft. From _____ ft. to _____ ft.
 From _____ ft. to _____ ft. From _____ ft. to _____ ft.

6 GROUT MATERIAL: 1 Neat cement 2 Cement grout 3 Bentonite 4 Other HOLE PLUG
 Grout Intervals: From 1 ft. to 20 ft., From _____ ft. to _____ ft., From _____ ft. to _____ ft.

What is the nearest source of possible contamination:
 1 Septic tank 4 Lateral lines 7 Pit privy 10 Livestock pens 14 Abandoned water well
 2 Sewer lines 5 Cess pool 8 Sewage lagoon 11 Fuel storage 15 Oil well/Gas well
 3 Watertight sewer lines 6 Seepage pit 9 Feedyard 12 Fertilizer storage 16 Other (specify below)
 13 Insecticide storage
 Direction from well? West How many feet? 150

FROM	TO	LITHOLOGIC LOG	FROM	TO	PLUGGING INTERVALS
0	3	TOP			
3	108	CLAY			
108	196	SAND & GRAVEL			
196	200	SANDY CLAY			
200	240	SAND W/ CLAY STREAKS			
240	348	SAND & GRAVEL			
348	368	CLAY			
368	448	SAND & GRAVEL			
448	460	CLAY			

7 CONTRACTOR'S OR LANDOWNER'S CERTIFICATION: This water well was (1) constructed, (2) reconstructed, or (3) plugged under my jurisdiction and was completed on (mo/day/year) 6-1-94 and this record is true to the best of my knowledge and belief. Kansas Water Well Contractor's License No. KWWCL-430. This Water Well Record was completed on (mo/day/yr) 6-1-94 under the business name of HOWARD DRIG.CO. BOX 806 BEAVER, OK 73932 by (signature) [Signature]