

USE TYPEWRITER OR BALL POINT PEN-PRESS FIRMLY, PRINT CLEARLY.

WATER WELL RECORD
KSA 82a-1201-1215

Kansas Department of Health and Environment-Division of Environment
(Water well Contractors)
Topeka, Kansas 66620

1. Location of well:	County Grant	Fraction SW 1/4 SE 1/4 NE 1/4	Section number 1	Township number T 29 S R 35	Range number EW
2. Distance and direction from nearest town or city: Street address of well location if in city:			3. Owner of well: R.R. or street: City, state, zip code:		
4. Locate with "X" in section below: N W E S 1 Mile 1 Mile			Sketch map: 		
5. Type and color of material			From	To	
					6. Bore hole dia. <u>26</u> in. Completion date <u>7-10-77</u> Well depth <u>460</u> ft.
					7. <input type="checkbox"/> Cable tool <input type="checkbox"/> Rotary <input type="checkbox"/> Driven <input type="checkbox"/> Dug <input type="checkbox"/> Hollow rod <input type="checkbox"/> Jetted <input type="checkbox"/> Bored <input checked="" type="checkbox"/> Reverse rotary
					8. Use: <input type="checkbox"/> Domestic <input type="checkbox"/> Public supply <input type="checkbox"/> Industry <input checked="" type="checkbox"/> Irrigation <input type="checkbox"/> Air conditioning <input type="checkbox"/> Stock <input type="checkbox"/> Lawn <input type="checkbox"/> Oil field water <input type="checkbox"/> Other
					9. Casing: Material <u>steel</u> Height: Above <u>surface</u> below Threaded <input type="checkbox"/> Welded <input checked="" type="checkbox"/> Surface <u>12</u> in. RMP <input type="checkbox"/> PVC <input type="checkbox"/> Weight <u>36.87</u> lbs./ft. Dia. <u>16</u> in. to <u>461</u> ft. depth Wall Thickness: inches or Dia. <u> </u> in. to <u> </u> ft. depth gage No. <u>250</u>
					10. Screen: Manufacturer's name <u>Johnson</u> Type <u>galv.</u> Dia. <u>16"</u> Slot/gauge <u> </u> Length <u>20</u> ft. Set between <u>340</u> ft. and <u>400</u> ft. Perf. <u>320-340</u> ft. and <u>400-460</u> ft. Gravel pack? <input checked="" type="checkbox"/> Yes Size range of material <u>2" down</u>
					11. Static water level: <u>250</u> ft. below land surface Date <u>6-27-77</u> mo./day/yr.
					12. Pumping level below land surfaces: <u>360</u> ft. after <u>6</u> hrs. pumping <u>1700</u> g.p.m. <u> </u> ft. after <u> </u> hrs. pumping <u> </u> g.p.m. Estimated maximum yield <u>1800</u> g.p.m.
					13. Water sample submitted: <u> </u> mo./day/yr. Yes <input type="checkbox"/> No <input checked="" type="checkbox"/> Date <u> </u>
					14. Well head completion: <u>12</u> Inches above grade <input type="checkbox"/> Pitless adapter
					15. Well grouted? <u>yes</u> With: <input type="checkbox"/> Neat cement <input type="checkbox"/> Bentonite <input checked="" type="checkbox"/> Concrete Depth: From <u>0</u> ft. to <u>10</u> ft.
					16. Nearest source of possible contamination: <u>N/A</u> ft. <u> </u> Direction <u> </u> Type <u> </u> Well disinfected upon completion? <input type="checkbox"/> Yes <input checked="" type="checkbox"/> No
					17. Pump: <u>Not installed</u> Manufacturer's name <u>Goold's</u> Model number <u>14M</u> HP <u>200</u> Volts <u> </u> Length of drop pipe <u>400</u> ft. capacity <u>1800</u> g.p.m. Type: <input type="checkbox"/> Submersible <input checked="" type="checkbox"/> Turbine <input type="checkbox"/> Jet <input type="checkbox"/> Reciprocating <input type="checkbox"/> Centrifugal <input type="checkbox"/> Other
18. Elevation:			19. Remarks:		
Topography: <input checked="" type="checkbox"/> Hill <input type="checkbox"/> Slope <input type="checkbox"/> Upland <input type="checkbox"/> Valley					
			20. Water well contractor's certification: This well was drilled under my jurisdiction and this report is true to the best of my knowledge and belief. <u>Minter-Wilson Drilling Co. 208</u> Business name License No. <u> </u> Address <u>Box A Garden City, Ks.</u> Signed <u>[Signature]</u> Date <u>7-30-77</u> Authorized representative		

Forward the white, blue and pink copies to the Department of Health and Environment

Form WWC-5

TEST HOLE LOG

Wagner's

Box 10, Ulysses, Kansas 67880

Water Wells & Test Holes

Phone (316) 356-2396


Test No. _____

Date _____

Qtr. _____ Sec. _____

Twp. _____ Rge. _____

Co. _____

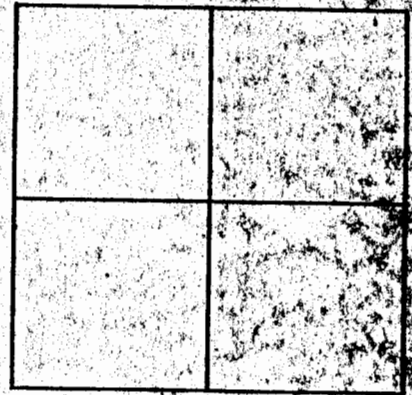

Land Owner Melvin Simpson

Address Galanta, Kansas

CONSOLIDATED-SALINA

520' E of west line

FOOTAGE	Description of Strata
0 - 20	Surface and fine sand
20 - 60	Sand
60 - 80	Coarse sand
80 - 100	Sand
100 - 240	Coarse sand
240 - 260	Coarse sand and clay string
260 - 280	Blue clay; Sand 275-280
280 - 420	Med. to coarse sand; Blue shale & some sandstone 415-420
420 - 460	Blue shale, sandstone & brown Choyenne
460 - 560	Blue shale

0 - 320 *plug*
 320 - 340 *perf*
 340 - 400 *screen*
 400 - 460 *perf*

Hole at 560 ft.

Set pump - 400' deep

*400' - 10" base
 2 1/2 x 1 1/4
 4 sty 1 1/4" bowl
 200' punch
 flange
 Drive shaft
 foundation*

*12,720.⁰⁰
 - 15,642.³⁴
 300.⁰⁰

 28,682.³⁴*

bid price