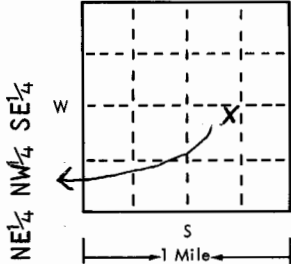
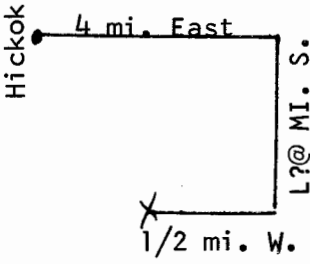


USE TYPEWRITER OR BALL POINT PEN-PRESS FIRMLY, PRINT CLEARLY.

WATER WELL RECORD  
KSA 82a-1201-1215

T R EW sec 1/4 1/4 1/4 No.

Kansas State Dept. Of Health  
(Water Well Contractors)  
Forbes-Bldg. 740  
Topeka, Kansas 66620

1 Location of well:	County <b>Grant</b>	Township name	Fraction <b>NE 1/4 NW 1/4 SE 1/4</b>	Section number <b>3</b>	Town number <b>T29S</b>	Range number <b>R35W</b>
Distance and direction from nearest town or city: <b>4 mi. E., 1/2 mi. S., 1/2 mi. W. of Hickok</b> Street address of well location if in city:				3 Owner of well: <b>Claude E. Merritt</b> Address: <b>120 North Simpson Ulysses, Kansas 67880</b>		
Locate with "X" in section below: N 		Sketch map: 		4 Well depth: <b>470</b> ft. Date of completion _____ Well diameter <b>26</b> in.		
				5 <input type="checkbox"/> Cable tool <input type="checkbox"/> Rotary <input type="checkbox"/> Driven <input type="checkbox"/> Dug <input type="checkbox"/> Hollow rod <input type="checkbox"/> Jetted <input type="checkbox"/> Bored <input checked="" type="checkbox"/> Reverse rotary		
				6 Use: <input type="checkbox"/> Domestic <input type="checkbox"/> Public supply <input type="checkbox"/> Industry <input checked="" type="checkbox"/> Irrigation <input type="checkbox"/> Air conditioning <input type="checkbox"/> Commercial <input type="checkbox"/> Test well <input type="checkbox"/> _____		
				7 Casing: Material <b>Steel</b> Height: above/below Threaded <input type="checkbox"/> Welded <input checked="" type="checkbox"/> Surface <b>12</b> in. Diam. _____ Weight <b>34 1/2</b> lbs./ft. _____ <b>1 1/2</b> in. to <b>470</b> ft. depth Drive shoe? <input type="checkbox"/> Yes <input checked="" type="checkbox"/> No		
2 Type and color of material				From	To	8 Screen: Manufacturer <b>Johnson</b> Type <b>Galvanized</b> Dia. <b>16"</b> Slot/gauge <b>100x100</b> Length <b>20'</b> Set between <b>360</b> ft. and <b>380</b> ft. _____ Fittings: * <b>See remarks</b> Gravel pack <input checked="" type="checkbox"/> Yes <input type="checkbox"/> No Size range of material <b>1/2</b> down
Surface				0	2	9 Static water level: <b>292</b> ft. below land surface Date <b>8-18-75</b>
Sandy Clay & Fine Sand				2	55	10 Pumping level below land surfaces: <b>310</b> ft. after <b>12</b> hrs. pumping <b>1600</b> g.p.m. _____ ft. after _____ hrs. pumping _____ g.p.m. Estimated maximum yield <b>2000</b> g.p.m.
Medium to Coarse Sand & Gravel				55	175	11 Water sample submitted: <input type="checkbox"/> Yes <input checked="" type="checkbox"/> No Date _____
Yellow Clay				175	198	12 Well head completion: <b>12"</b> <input type="checkbox"/> Pitless adapter <input checked="" type="checkbox"/> Inches above grade
Medium to Coarse Sand & Gravel				198	237	13 Well grouted? <input checked="" type="checkbox"/> Yes <input type="checkbox"/> No <input checked="" type="checkbox"/> Neat cement <input checked="" type="checkbox"/> Bentonite <input type="checkbox"/> _____ Depth: From <b>0</b> ft. to <b>10</b> ft.
" " " " "				237	260	14 Nearest source of possible contamination: <b>in field</b> ft. _____ Direction <b>none</b> Type _____ Well disinfected upon completion? <input type="checkbox"/> Yes <input checked="" type="checkbox"/> No
" " " " "				260	335	15 Pump: <input type="checkbox"/> Not installed Manufacturer's name <b>Goulds</b> Model number <b>14J</b> HP <b>150</b> Volts _____ Length of drop pipe <b>340</b> ft. capacity <b>2000</b> m.p. Type: <input type="checkbox"/> Submersible <input checked="" type="checkbox"/> Turbine <input type="checkbox"/> Jet <input type="checkbox"/> Reciprocating <input type="checkbox"/> Centrifugal <input type="checkbox"/> Other
Sandy Clay - Some Loose Strips				335	385	16 Remarks: elevation Drilling Sub-contracted to: <b>Minter-Wilson Drilling Co. License #208</b> <b>Garden City, Kansas</b>  * Lakewood Peforation - Slot - .125 X 66 Set between 240' & 360' and 380' & 470'
Brown Shale & Sandrock				385	465	17 Water well contractor's certification: This well was drilled under my jurisdiction and this report is true to the best of my knowledge and belief. <b>K. I. Drilling Co., Inc. 263</b> Business name License No. Address <b>Box 669, Ulysses, Kan.</b> Signed <b>Bob Harker</b> Date <b>8-26-75</b> Authorized representative
Rock				465	480	
(use a second sheet if needed)						
16 Remarks: elevation Topography: <input type="checkbox"/> Hill <input checked="" type="checkbox"/> Slope <input type="checkbox"/> Upland <input type="checkbox"/> Valley						