


1 LOCATION OF WATER WELL: Fraction C 1/4 SW 1/4 NW 1/4 Section Number 10 Township Number T 29 S Range Number R 35 EW

Distance and direction from nearest town or city street address of well if located within city?
 From Ulysses, KS: 12 E, 1 3/8 S and 1/2 E into--

2 WATER WELL OWNER: OXY USA, Inc.
 RR#, St. Address, Box # : P.O. Box 26100 Board of Agriculture, Division of Water Resources
 City, State, ZIP Code : Oklahoma City, OK 73126-0100 Application Number: 900098

3 LOCATE WELL'S LOCATION WITH AN "X" IN SECTION BOX:

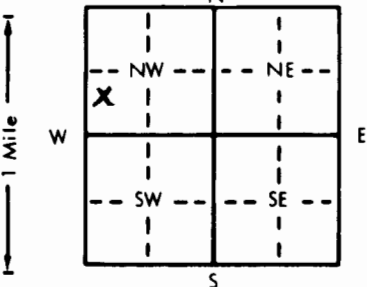

4 DEPTH OF COMPLETED WELL: 420 ft. ELEVATION:
 Depth(s) Groundwater Encountered 1. 285 ft. 2. ft. 3. ft.
 WELL'S STATIC WATER LEVEL: 285 ft. below land surface measured on mo/day/yr 03-12-90
 Pump test data: Well water was 295 ft. after 1 hours pumping 90 gpm
 Est. Yield 90 gpm: Well water was ft. after hours pumping gpm
 Bore Hole Diameter: 10 1/2 in. to 420 ft., and in. to ft.
 WELL WATER TO BE USED AS:
 5 Public water supply 8 Air conditioning 11 Injection well
 1 Domestic 3 Feedlot 6 Oil field water supply 9 Dewatering 12 Other (Specify below)
 2 Irrigation 4 Industrial 7 Lawn and garden only 10 Monitoring well
 Was a chemical/bacteriological sample submitted to Department? Yes No X; If yes, mo/day/yr sample was submitted
 Water Well Disinfected? Yes X No

5 TYPE OF BLANK CASING USED:
 1 Steel 3 RMP (SR) 5 Wrought iron 8 Concrete tile CASING JOINTS: Glued X Clamped
 2 PVC 4 ABS 6 Asbestos-Cement 9 Other (specify below) Welded
 7 Fiberglass Threaded
 Blank casing diameter 6 5/8 in. to 420 ft., Dia. in. to ft., Dia. in. to ft.
 Casing height above land surface 24 in., weight lbs./ft. Wall thickness or gauge No. 280

TYPE OF SCREEN OR PERFORATION MATERIAL:
 1 Steel 3 Stainless steel 5 Fiberglass 7 PVC 10 Asbestos-cement
 2 Brass 4 Galvanized steel 6 Concrete tile 8 RMP (SR) 11 Other (specify)
 9 ABS 12 None used (open hole)

SCREEN OR PERFORATION OPENINGS ARE:
 1 Continuous slot 3 Mill slot 5 Gauzed wrapped 8 Saw cut 11 None (open hole)
 2 Louvered shutter 4 Key punched 6 Wire wrapped 9 Drilled holes
 7 Torch cut 10 Other (specify)

SCREEN-PERFORATED INTERVALS: From 340 ft. to 420 ft. From ft. to ft.
 From ft. to ft. From ft. to ft.
 GRAVEL PACK INTERVALS: From 250 ft. to 420 ft. From ft. to ft.
 From ft. to ft. From ft. to ft.

6 GROUT MATERIAL: 1 Neat cement 2 Cement grout 3 Bentonite 4 Other dirt
 Grout Intervals: From 1 ft. to 20 ft. From ft. to ft. From ft. to ft.
 What is the nearest source of possible contamination:
 1 Septic tank 4 Lateral lines 7 Pit privy 10 Livestock pens 14 Abandoned water well
 2 Sewer lines 5 Cess pool 8 Sewage lagoon 11 Fuel storage 15 Oil well/Gas well
 3 Watertight sewer lines 6 Seepage pit 9 Feedyard 12 Fertilizer storage 16 Other (specify below)
 13 Insecticide storage
 Direction from well? Northwest How many feet? 160

FROM	TO	LITHOLOGIC LOG	FROM	TO	PLUGGING INTERVALS
0	4	Top soil	287	312	Tan Clay
4	18	Tan Clay	312	329	Tan Sandy Clay
18	49	Tan Sandy Clay	329	420	Medium Sand and Gravel
49	68	Sand			
68	77	Tan Clay			
77	151	Sand			
151	165	Tan Clay			
165	176	Tan Sandy Clay			
176	184	Yellow Clay			
184	212	Medium Sand			
212	218	Tan Clay			
218	246	Green-Tan Clay			
246	257	Sand			
257	268	Tan Clay			
268	287	Medium Sand			

7 CONTRACTOR'S OR LANDOWNER'S CERTIFICATION: This water well was 1 constructed, (2) reconstructed, or (3) plugged under my jurisdiction and was completed on (mo/day/year) 03-12-90 and this record is true to the best of my knowledge and belief. Kansas Water Well Contractor's License No. KWCL-430 This Water Well Record was completed on (mo/day/yr) 03-12-90 under the business name of Howard Drlg.Co. Box 806 Beaver, OK 73932 by (signature) Howard Drlg.Co.

INSTRUCTIONS: Use typewriter or ball point pen. PLEASE PRESS FIRMLY and PRINT clearly. Please fill in blanks, underline or circle the correct answers. Send top three copies to Kansas Department of Health and Environment, Bureau of Water Protection, Topeka, Kansas 66620-7320. Telephone: 913-296-5514. Send one to WATER WELL OWNER and retain one for your records.