


1 LOCATION OF WATER WELL: Fraction $\frac{1}{4}$ N C $\frac{1}{4}$ SE $\frac{1}{4}$ Section Number 18 Township Number T 29 S Range Number R 35 EW

Distance and direction from nearest town or city street address of well if located within city?
 From Ulysses: 10 E, 2 3/4 S and 1/4 W into--

2 WATER WELL OWNER: OXY USA, Inc. OXY applied for--
 RR#, St. Address, Box #: P.O. Box 26100 Board of Agriculture, Division of Water Resources
 City, State, ZIP Code: Oklahoma City, OK 73126 Application Number:

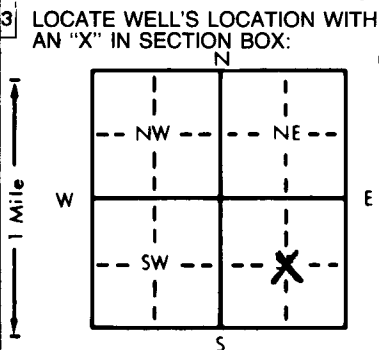

4 DEPTH OF COMPLETED WELL: 480 ft. ELEVATION: ...
 Depth(s) Groundwater Encountered 1. 210 ft. 2. ... ft. 3. ... ft.
 WELL'S STATIC WATER LEVEL 210 ft. below land surface measured on mo/day/yr 6-19-90
 Pump test data: Well water was 240 ft. after 1 hours pumping 90 gpm
 Est. Yield 90 gpm: Well water was ... ft. after ... hours pumping ... gpm
 Bore Hole Diameter 11 in. to 480 ft., and ... in. to ... ft.
 WELL WATER TO BE USED AS:
 5 Public water supply 8 Air conditioning 11 Injection well
 1 Domestic 3 Feedlot 6 Oil field water supply 9 Dewatering 12 Other (Specify below)
 2 Irrigation 4 Industrial 7 Lawn and garden only 10 Monitoring well
 Was a chemical/bacteriological sample submitted to Department? Yes ... No X; If yes, mo/day/yr sample was submitted
 Water Well Disinfected? Yes X No

5 TYPE OF BLANK CASING USED:
 1 Steel 3 RMP (SR) 5 Wrought iron 8 Concrete tile CASING JOINTS: Glued X Clamped
2 PVC 4 ABS 6 Asbestos-Cement 9 Other (specify below) Welded
 7 Fiberglass Threaded
 Blank casing diameter 6 in. to 480 ft., Dia ... in. to ... ft., Dia ... in. to ... ft.
 Casing height above land surface 24 in., weight ... lbs./ft. Wall thickness or gauge No. 032
 TYPE OF SCREEN OR PERFORATION MATERIAL:
 1 Steel 3 Stainless steel 5 Fiberglass 7 PVC 10 Asbestos-cement
 2 Brass 4 Galvanized steel 6 Concrete tile 8 RMP (SR) 11 Other (specify)
 9 ABS 12 None used (open hole)
 SCREEN OR PERFORATION OPENINGS ARE:
 1 Continuous slot 3 Mill slot 5 Gauzed wrapped 8 Saw cut 11 None (open hole)
 2 Louvered shutter 4 Key punched 6 Wire wrapped 9 Drilled holes
 7 Torch cut 10 Other (specify)
 SCREEN-PERFORATED INTERVALS: From 340 ft. to 480 ft., From ... ft. to ... ft.
 GRAVEL PACK INTERVALS: From 300 ft. to 480 ft., From ... ft. to ... ft.

6 GROUT MATERIAL: 1 Neat cement 2 Cement grout 3 Bentonite 4 Other dirt
 Grout Intervals: From 1 ft. to 20 ft., From ... ft. to ... ft., From ... ft. to ... ft.
 What is the nearest source of possible contamination:
 1 Septic tank 4 Lateral lines 7 Pit privy 10 Livestock pens 14 Abandoned water well
 2 Sewer lines 5 Cess pool 8 Sewage lagoon 11 Fuel storage 15 Oil well/Gas well
 3 Watertight sewer lines 6 Seepage pit 9 Feedyard 12 Fertilizer storage 16 Other (specify below)
 13 Insecticide storage
 Direction from well? South How many feet? 145

FROM	TO	LITHOLOGIC LOG	FROM	TO	PLUGGING INTERVALS
0	8	Sand			
8	21	Clay			
21	40	Sandy Clay			
40	51	Clay			
51	170	Clay			
170	290	Blue Clay			
290	344	Clay			
344	352	Sand			
352	441	Clay			
441	470	Sand			
470	480	Clay			

7 CONTRACTOR'S OR LANDOWNER'S CERTIFICATION: This water well was 1 constructed, (2) reconstructed, or (3) plugged under my jurisdiction and was completed on (mo/day/year) 06-16-90 and this record is true to the best of my knowledge and belief. Kansas Water Well Contractor's License No. KWWCL-430 This Water Well Record was completed on (mo/day/yr) 06-16-90 under the business name of Howard Drlg. Co. Box 806 Beaver, OK 73932 by (signature) *Howard Drlg. Co.*

INSTRUCTIONS: Use typewriter or ball point pen. PLEASE PRESS FIRMLY and PRINT clearly. Please fill in blanks, underline or circle the correct answers. Send top three copies to Kansas Department of Health and Environment, Bureau of Water Protection, Topeka, Kansas 66620-7320. Telephone: 913-298-5514. Send one to WATER WELL OWNER and retain one for your records.

OFFICE USE ONLY
T
R
EW
SEC.
1/4
1/4
1/4