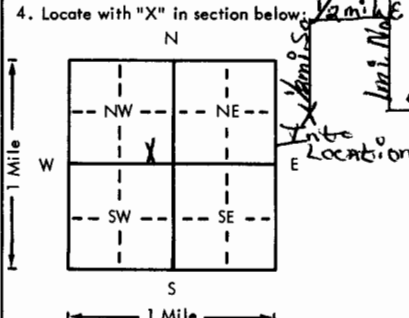


USE TYPEWRITER OR BALL POINT PEN-PRESS FIRMLY, PRINT CLEARLY.

WATER WELL RECORD  
KSA 82a-1201-1215

Kansas Department of Health and Environment-Division of Environment  
(Water well Contractors)  
Topeka, Kansas 66620

CWW Inv. #12514 King #4

1. Location of well:		County <b>Grant</b>	Fraction <b>1/4 SE 1/4 NW 1/4</b>	Section number <b>19</b>	Township number <b>T 29 S R 35 E/W</b>	Range number <b>35</b>
2. Distance and direction from nearest town or city: <b>From Satanta go NW on hwy 190 to Ryus - 1 mi. No. - 4 mi We. - 1 mi. No. - 1/2 mi. We. - 1/2 mi So. to loc.</b>			3. Owner of well: <b>Zenith Drilling Company</b> R.R. or street: <b>Suite 600, 200 West Douglas</b> City, state, zip code: <b>Wichita, Kansas 67202</b>			
4. Locate with "X" in section below: 			Sketch map: <b>4 mi We.</b> <b>1/2 mi So.</b> <b>Ryus</b> <b>North West Hwy. #190</b> <b>Satanta</b>			
5. Type and color of material			From	To	6. Bore hole dia. <b>9</b> in. Completion date <b>7/23</b> Well depth <b>400</b> ft.	
Surface			0	2	7. <input checked="" type="checkbox"/> Cable tool <input checked="" type="checkbox"/> Rotary <input type="checkbox"/> Driven <input type="checkbox"/> Dug <input type="checkbox"/> Hollow rod <input type="checkbox"/> Jetted <input type="checkbox"/> Bored <input type="checkbox"/> Reverse rotary	
Sandy clay			2	90	8. Use: <input type="checkbox"/> Domestic <input type="checkbox"/> Public supply <input checked="" type="checkbox"/> Industry <input type="checkbox"/> Irrigation <input type="checkbox"/> Air conditioning <input type="checkbox"/> Stock <input type="checkbox"/> Lawn <input checked="" type="checkbox"/> Oil field water <input type="checkbox"/> Other	
Fine Sand			90	100	9. Casing: Material _____ Height: Above or below Threaded _____ Welded _____ Surface <b>28</b> in. RMP _____ PVC <input checked="" type="checkbox"/> Weight <b>2.78</b> lbs./ft. Dia. <b>5</b> in. to <b>295</b> ft. depth Wall Thickness: inches or Dia. <b>3</b> in. to <b>400</b> ft. depth gage No. <b>.265</b>	
Blue and Brown clay			100	250	10. Screen: Manufacturer's name _____ <b>Sawed Perf.</b> Type <b>PVC</b> Dia. <b>5"</b> Slot/gauze <b>.030</b> Length <b>100'</b> Set between <b>295</b> ft. and <b>395</b> ft. Set between _____ ft. and _____ ft. Gravel pack? <input checked="" type="checkbox"/> Yes <input type="checkbox"/> No Size range of material <b>1/8-3/16</b>	
Med. to lge. sand & sandy clay 70-30			250	260	11. Static water level: _____ mo./day/yr. <b>290</b> ft. below land surface Date <b>7/23/76</b>	
Clay			260	290	12. Pumping level below land surfaces: _____ ft. after _____ hrs. pumping _____ g.p.m. _____ ft. after _____ hrs. pumping _____ g.p.m. Estimated maximum yield <b>50</b> g.p.m.	
Med. to lge. sand & sandy clay 60-40			290	300	13. Water sample submitted: _____ mo./day/yr. <input type="checkbox"/> Yes <input checked="" type="checkbox"/> No Date _____	
Med. to lge. sand			300	350	14. Well head completion: <input type="checkbox"/> Pitless adapter <b>28</b> inches above grade	
Med. to lge. sand & sandy clay 70-30			350	400	15. Well grouted? <input checked="" type="checkbox"/> yes With: <input checked="" type="checkbox"/> Neat cement <input type="checkbox"/> Bentonite <input type="checkbox"/> Concrete Depth: From <b>0</b> ft. to <b>10</b> ft.	
					16. Nearest source of possible contamination: ft. <b>100</b> Direction <b>NE</b> Type <b>oilwell</b> Well disinfected upon completion? <input checked="" type="checkbox"/> Yes <input type="checkbox"/> No	
					17. Pump: <input checked="" type="checkbox"/> Not installed Manufacturer's name _____ Model number _____ HP _____ Volts _____ Length of drop pipe _____ ft. capacity _____ g.p.m. Type: <input type="checkbox"/> Submersible <input type="checkbox"/> Turbine <input type="checkbox"/> Jet <input type="checkbox"/> Reciprocating <input type="checkbox"/> Centrifugal <input type="checkbox"/> Other	
					20. Water well contractor's certification: This well was drilled under my jurisdiction and this report is true to the best of my knowledge and belief. <b>Carlile Water Well Service 118</b> Business name _____ License No. _____ Address <b>Box 275, Liberal, Ks.</b> Signed: <b>Edward E. Means</b> Date <b>8/11</b> Authorized representative	
18. Elevation:		19. Remarks:				
Topography: <input type="checkbox"/> Hill <input type="checkbox"/> Slope <input checked="" type="checkbox"/> Upland <input type="checkbox"/> Valley						

29  
 35  
 19  
 SE  
 1/4  
 1/4  
 1/4