

USE TYPEWRITER OR BALL POINT PEN—PRESS FIRMLY, PRINT CLEARLY.


WATER WELL RECORD
KSA 82a-1201-1215

T R EW sec 1/4 1/4 1/4 No.

Kansas State Dept. Of Health
(Water Well Contractors)
Forbes-Bldg. 740
Topeka, Kansas 66620

1 Location of well:	County Grant	Township name	Fraction SE¹/₄, SE¹/₄, NE¹/₄	Section number 20	Town number T-29-S	Range number R-35-W
---------------------	------------------------	---------------	--	-----------------------------	------------------------------	-------------------------------

Distance and direction from nearest town or city: 3 mi. E., 3 mi. S., 1 mi. E. & 1/2 mi. S Street address of well location if in city: of Ryus	3 Owner of well: Claude King Address: Route 1 Ulysses, Kansas 67880
---	--

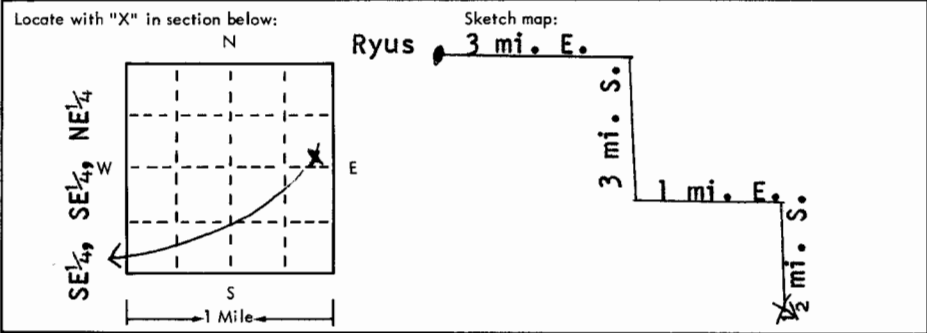

4 Well depth: 545 ft. Date of completion 11-14-75
Well diameter 26 in.

5 Cable tool Rotary Driven Dug
 Hollow rod Jetted Bored Reverse rotary

6 Use: Domestic Public supply Industry
 Irrigation Air conditioning Commercial
 Test well

7 Casing: Material Steel Height: above/below
Threaded Welded Surface 12 in.
Diam. 16 in. Weight 34 1/2 lbs./ft.
16 in. to 545 ft. depth! Drive shoe? Yes No
___ in. to ___ ft. depth!

2	Type and color of material	From	To
	Surface & Fine Sand	0	15
	Brown Clay	15	45
	Sand	45	90
	Brown Clay	90	105
	Sand	105	120
	Brown Clay	120	210
	Sand	210	315
	Sand & Brown Clay 70%	315	330
	Blue Clay	330	345
	Sand - Good	345	370
	Brown Clay	370	435
	Coarse Sand	435	525
	Sand, Rock & Clay Strips	525	540
	Brown Shale	540	570
	(use a second sheet if needed)		

8 Screen:
Manufacturer Johnson
Type Galvanized Dia. 16 in.
Slot/size 100x100 Length 70 ft.
Set between 455 ft. and 525 ft.
Fittings: * See Remarks
Gravel pack Yes No Size range of material 1/2 down

9 Static water level:
267 ft. below land surface Date 11-14-75

10 Pumping level below land surfaces:
300 ft. after 2 hrs. pumping 800 g.p.m.
___ ft. after ___ hrs. pumping ___ g.p.m.
Estimated maximum yield 1000 g.p.m.

11 Water sample submitted:
 Yes No Date _____

12 Well head completion: 12 in.
 Pitless adapter Inches above grade

13 Well grouted? Yes No
 Neat cement Bentonite ___
Depth: From 0 ft. to 10 ft.

14 Nearest source of possible contamination:
ft. ___ Direction none in field Type ___
Well disinfected upon completion? Yes No

15 Pump: Not installed
Manufacturer's name Goulds
Model number 12 J HP 150 Volts ___
Length of drop pipe 400 ft. capacity 1200 g.p.m.
Type:
 Submersible Turbine
 Jet Reciprocating
 Centrifugal Other

16 Remarks: elevation **Drilling Sub-contracted to:
Minter-Wilson Drilling Co. License #208
Garden City, Kansas 67846
* Lakewood - Slot - .125 X 66
Set between 435' & 455' and 525' & 545'**

Topography:
 Hill
 Slope
 Upland
 Valley

17 Water well contractor's certification:
This well was drilled under my jurisdiction and this report is true to the best of my knowledge and belief.
K. I. Drilling Co., Inc. 263
Business name License No.
Address Box 669, Ulysses, Kan.
Signed Bob Jankov Date 11-20-75
Authorized representative

29 35W 20 SE SE NE