

USE TYPEWRITER OR BALL POINT PEN-PRESS FIRMLY, PRINT CLEARLY.

T R EW sec 1/4 1/4 1/4 No.

WATER WELL RECORD
KSA 82a-1201-1215

Kansas State Dept. Of Health
(Water Well Contractors)
Forbes-Bldg. 740
Topeka, Kansas 66620


1 Location of well:	County Grant	Township name	Fraction NE 1/4 SW 1/4 SW 1/4	Section number 28	Town number T29S	Range number R35W
---------------------	------------------------	---------------	---	-----------------------------	----------------------------	-----------------------------

Distance and direction from nearest town or city:
1 Mi. East, 5 S., 3 East, 1/4 NE. of Hickok, Kansas
Street address of well location if in city:

3 Owner of well:
Kathrine Pusey
Address:
**Fields Court
Newton, Kansas**

Locate with "X" in section below:

Sketch map:

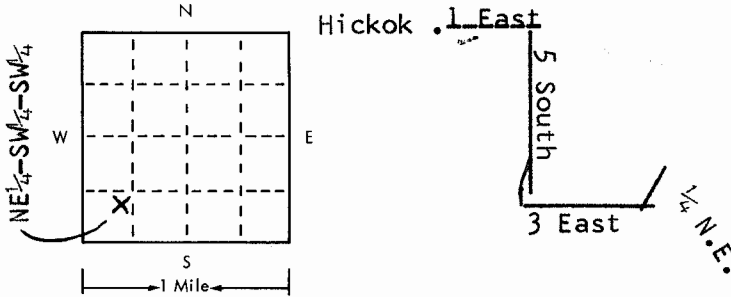

4 Well depth: **485** ft. Date of completion **2-28-75**
Well diameter **26** in.

5 Cable tool Rotary Driven Dug
 Hollow rod Jetted Bored Reverse rotary

6 Use: Domestic Public supply Industry
 Irrigation Air conditioning Commercial
 Test well

7 Casing: Material **steel** Height: above **4** ft.
Threaded Welded Surface **12** in.
Diam. **16** in. Weight **34.25** lbs./ft.
to **385** ft. depth! Drive shoe? Yes No

2	Type and color of material	From	To
	Surface & Fine Sand	0	15
	Sand	15	30
	Brown Clay	30	45
	Sand with 5' Brown Clay	45	75
	Blue Clay	75	210
	Coarse sand with Brown Clay (225-240)	210	255
	Brown Clay	255	300
	Coarse Sand	300	370
	Brown Clay	370	375
	Brown & Red Clay & Lava Rock	375	405
	Red Clay, Yellow Clay, back to Red Clay	405	435
	Yellow Chalk & Brown Cheyenne	435	450
	Brown Cheyenne (Loose)	450	485
	Yellow Chalk; Blue & Brown Shale	485	510
	Blue & Brown Shale to Red Bed	510	525
	(use a second sheet if needed)		

8 Screen:
Manufacturer **Lakewood**
Type **Steel** Dia. **16th**
Slot/gauze **125x66** Length **245'**
Set between **240** ft. and **485** ft.
Fittings:
Gravel pack Yes No Size range of material **1/2** DOWN

9 Static water level:
±10 ft. below land surface Date **3-6-75**

10 Pumping level below land surfaces:
240 ft. after **4** hrs. pumping **300** g.p.m.
ft. after _____ hrs. pumping _____ g.p.m.
Estimated maximum yield **1200** g.p.m.

11 Water sample submitted:
 Yes No Date _____

12 Well head completion: **12"**
 Pitless adapter Inches above grade

13 Well grouted? Yes No
 Neat cement Bentonite _____
Depth: From **0** ft. to **10** ft.

14 Nearest source of possible contamination: **in field**
ft. _____ Direction **none** Type _____
Well disinfected upon completion? Yes No

15 Pump: Not installed
Manufacturer's name **Goulds**
Model number **12J** HP **150** Volts _____
Length of drop pipe **340** ft. capacity **1200** g.p.m.
Type:
 Submersible Turbine
 Jet Reciprocating
 Centrifugal Other

16 Remarks: elevation
**Drilling Sub-Contracted to:
Minter-Wilson Drilling Co. License #208
Garden City, Kansas 67846**

Topography:

- Hill
 Slope
 Upland
 Valley

17 Water well contractor's certification:
This well was drilled under my jurisdiction and this report is true to the best of my knowledge and belief.

K. I. Drilling Co. **263**
Business name License No.
Address **Box 669, Illysses, Kan.**
Signed **[Signature]** Date **2-1-75**
Authorized representative