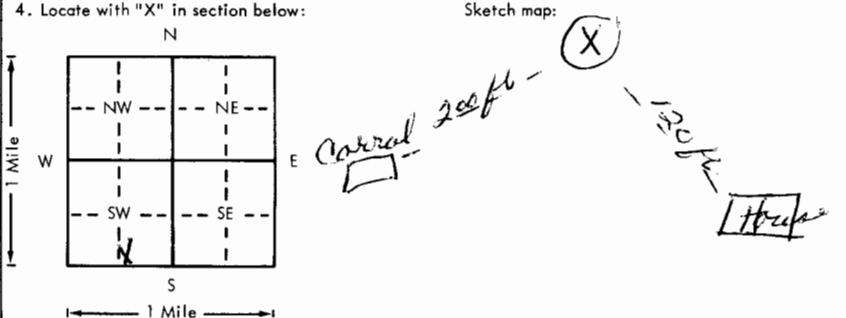


USE TYPEWRITER OR BALL POINT PEN-PRESS FIRMLY, PRINT CLEARLY.

WATER WELL RECORD
KSA 82a-1201-1215

Kansas Department of Health and Environment-Division of Environment (Water well Contractors) Topeka, Kansas 66620

1. Location of well:		County Grant	Fraction SW 1/4 SE 1/4 SW 1/4	Section number 35	Township number T 29 S R 35	Range number 35																														
2. Distance and direction from nearest town or city: 6/10 west of four way 14 east, 6 South Street address of well location if in stop at Ulysses				3. Owner of well: Combs Hampton R.R. or street: Ulysses, Ks. 68888 67880 City, state, zip code:																																
4. Locate with "X" in section below: 				6. Bore hole dia. 9 1/2 in. Completion date 5/18/78 Well depth 470 ft.																																
5. Type and color of material				7. <input checked="" type="checkbox"/> Cable tool <input checked="" type="checkbox"/> Rotary <input type="checkbox"/> Driven <input type="checkbox"/> Dug <input type="checkbox"/> Hollow rod <input type="checkbox"/> Jetted <input type="checkbox"/> Bored <input type="checkbox"/> Reverse rotary																																
<table border="1" style="width:100%; border-collapse: collapse;"> <thead> <tr> <th></th> <th>From</th> <th>To</th> </tr> </thead> <tbody> <tr> <td>Surface</td> <td>0</td> <td>2</td> </tr> <tr> <td>Very fine to fine sand</td> <td>2</td> <td>15</td> </tr> <tr> <td>Gummy clay w/fine sand</td> <td>15</td> <td>90</td> </tr> <tr> <td>Medium to coarse sand w/clay breakers</td> <td>90</td> <td>183</td> </tr> <tr> <td>Sandy clay w/fine sand strips</td> <td>183</td> <td>258</td> </tr> <tr> <td>Medium to coarse sand w/clay breakers</td> <td>258</td> <td>345</td> </tr> <tr> <td>Sandy clay w/fine sand strips</td> <td>345</td> <td>378</td> </tr> <tr> <td>Medium to coarse sand</td> <td>378</td> <td>440</td> </tr> <tr> <td>Sandy clay & lime shells</td> <td>440</td> <td>470</td> </tr> </tbody> </table>					From	To	Surface	0	2	Very fine to fine sand	2	15	Gummy clay w/fine sand	15	90	Medium to coarse sand w/clay breakers	90	183	Sandy clay w/fine sand strips	183	258	Medium to coarse sand w/clay breakers	258	345	Sandy clay w/fine sand strips	345	378	Medium to coarse sand	378	440	Sandy clay & lime shells	440	470	8. Use: <input checked="" type="checkbox"/> Domestic <input type="checkbox"/> Public supply <input type="checkbox"/> Industry <input type="checkbox"/> Irrigation <input type="checkbox"/> Air conditioning <input type="checkbox"/> Stock <input type="checkbox"/> Lawn <input type="checkbox"/> Oil field water <input type="checkbox"/> Other		
	From	To																																		
Surface	0	2																																		
Very fine to fine sand	2	15																																		
Gummy clay w/fine sand	15	90																																		
Medium to coarse sand w/clay breakers	90	183																																		
Sandy clay w/fine sand strips	183	258																																		
Medium to coarse sand w/clay breakers	258	345																																		
Sandy clay w/fine sand strips	345	378																																		
Medium to coarse sand	378	440																																		
Sandy clay & lime shells	440	470																																		
				9. Casing: Material styrene Height: 18 Above or below glued and riveted Treaded <input type="checkbox"/> Welded <input type="checkbox"/> Surface <input type="checkbox"/> in. RMP <input type="checkbox"/> PVC <input type="checkbox"/> Weight <input type="checkbox"/> lbs./ft. Dia. 5 in. to 410 ft. depth Wall Thickness: <input type="checkbox"/> in. or Dia. <input type="checkbox"/> in. to <input type="checkbox"/> ft. depth gage No. 320																																
				10. Screen: Manufacturer's name Sunflower Type styrene Dia. 5" Slot/gauze 1/16" Length 60 Set between 410 ft. and 470 ft. <input type="checkbox"/> ft. and <input type="checkbox"/> ft. Gravel pack? <input checked="" type="checkbox"/> Size range of material 1/4"																																
				11. Static water level: 278 ft. below land surface Date 5/12/78 <small>mo./day/yr.</small>																																
				12. Pumping level below land surfaces: 282 ft. after 6 hrs. pumping 20 g.p.m. <input type="checkbox"/> ft. after <input type="checkbox"/> hrs. pumping <input type="checkbox"/> g.p.m. Estimated maximum yield 50 g.p.m.																																
				13. Water sample submitted: <input type="checkbox"/> Yes <input checked="" type="checkbox"/> No Date <input type="checkbox"/>																																
				14. Well head completion: <input checked="" type="checkbox"/> Pitless adapter 18 Inches above grade																																
				15. Well grouted? <input checked="" type="checkbox"/> With: <input checked="" type="checkbox"/> Neat cement <input type="checkbox"/> Bentonite <input type="checkbox"/> Concrete Depth: From 0 ft. to 12 ft.																																
				16. Nearest source of possible contamination: corral ft. 200 Direction SE Type XXXXXX Well disinfected upon completion? <input checked="" type="checkbox"/> Yes <input type="checkbox"/> No																																
				17. Pump: <input checked="" type="checkbox"/> Not installed Manufacturer's name <input type="checkbox"/> Model number <input type="checkbox"/> HP <input type="checkbox"/> Volts <input type="checkbox"/> Length of drop pipe <input type="checkbox"/> ft. capacity <input type="checkbox"/> g.p.m. Type: <input type="checkbox"/> Submersible <input type="checkbox"/> Turbine <input type="checkbox"/> Jet <input type="checkbox"/> Reciprocating <input type="checkbox"/> Centrifugal <input type="checkbox"/> Other																																
(Use a second sheet if needed)																																				
18. Elevation:		19. Remarks:		20. Water well contractor's certification: This well was drilled under my jurisdiction and this report is true to the best of my knowledge and belief. Houck Bros. Drig. Co. 164 Business name Box 487, Ulysses, Ks. License No. <input type="checkbox"/> Address <input type="checkbox"/> Signed M. Beard Date 5/20/78 Authorized representative																																
Topography: <input type="checkbox"/> Hill <input checked="" type="checkbox"/> Slope <input type="checkbox"/> Upland <input type="checkbox"/> Valley																																				

T 29 S R 35
 Sec 35
 SW SE SW
 1/4 1/4 1/4

Forward the white, blue and pink copies to the Department of Health and Environment

Form WWC-5