

USE TYPEWRITER OR BALL POINT PEN-PRESS FIRMLY, PRINT CLEARLY.


T R EW sec 1/4 1/4 1/4 No.

WATER WELL RECORD
KSA 82a-1201-1215

Kansas State Dept. Of Health
(Water Well Contractors)
Forbes-Bldg. 740
Topeka, Kansas 66620

1 Location of well:	County Grant	Township name	Fraction SW¹/₄, SW¹/₄, NE¹/₄	Section number 35	Town number T-29-S	Range number R-35-W
---------------------	------------------------	---------------	--	-----------------------------	------------------------------	-------------------------------

Distance and direction from nearest town or city: 1/2 mi. South & 1/2 mi. West of Ryus Street address of well location if in city:	3 Owner of well: Address: Claude Merritt 120 North Simpson Ulysses, Kansas 67880
---	---

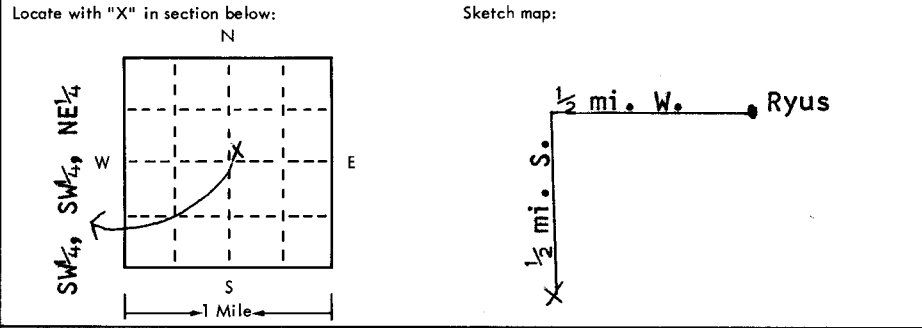

4 Well depth: 510 ft. Date of completion 11-19-75 Well diameter 26 in.
5 <input type="checkbox"/> Cable tool <input type="checkbox"/> Rotary <input type="checkbox"/> Driven <input type="checkbox"/> Dug <input type="checkbox"/> Hollow rod <input type="checkbox"/> Jetted <input type="checkbox"/> Bored <input checked="" type="checkbox"/> Reverse rotary
6 Use: <input type="checkbox"/> Domestic <input type="checkbox"/> Public supply <input type="checkbox"/> Industry <input checked="" type="checkbox"/> Irrigation <input type="checkbox"/> Air conditioning <input type="checkbox"/> Commercial <input type="checkbox"/> Test well <input type="checkbox"/>
7 Casing: Material Steel Height: above/below Threading: <input type="checkbox"/> Threaded <input type="checkbox"/> Welded <input checked="" type="checkbox"/> Surface 12 in. Diam. 16 in. to 510 ft. depth! Drive shoe? <input type="checkbox"/> Yes <input checked="" type="checkbox"/> No Weight 3 3/4 lbs./ft. <input type="checkbox"/> Yes <input checked="" type="checkbox"/> No

2 Type and color of material	From	To
Surface & Brown Clay	0	15
Brown Clay	15	105
XXXXX Sand	105	120
XXXXXXXXXXXX Coarse Sand	120	195
Brown Sandy Clay	195	240
Coarse Sand	240	315
Brown Clay	315	340
Coarse Sand	340	480
Sand & Brown Clay - 50%	480	510
Brown Clay	510	580
Red Bed	580	585
(use a second sheet if needed)		

8 Screen: Manufacturer Johnson Type Galvanized Dia. 16in. Slot size 100x100 Length 40 Ft. Set between 430 ft. and 470 ft. Fittings: * See Remarks Gravel pack <input checked="" type="checkbox"/> Yes <input type="checkbox"/> No Size range of material 1/2 down
9 Static water level: 262 ft. below land surface Date 11-17-75
10 Pumping level below land surfaces: 320 ft. after 2 hrs. pumping 1400 g.p.m. ____ ft. after ____ hrs. pumping ____ g.p.m. Estimated maximum yield 2000 g.p.m.
11 Water sample submitted: <input type="checkbox"/> Yes <input checked="" type="checkbox"/> No Date _____
12 Well head completion: 12 in. <input type="checkbox"/> Pitless adapter <input checked="" type="checkbox"/> Inches above grade
13 Well grouted? <input checked="" type="checkbox"/> Yes <input type="checkbox"/> No <input checked="" type="checkbox"/> Neat cement <input checked="" type="checkbox"/> Bentonite <input type="checkbox"/> _____ Depth: From 0 ft. to 10 ft.
14 Nearest source of possible contamination: ft. _____ Direction None in Field Well disinfected upon completion? <input type="checkbox"/> Yes <input checked="" type="checkbox"/> No
15 Pump: <input type="checkbox"/> Not installed Manufacturer's name Goulds Model number 14J HP 200 Volts _____ Length of drop pipe 380 ft. capacity 2000 g.p.m. Type: <input type="checkbox"/> Submersible <input checked="" type="checkbox"/> Turbine <input type="checkbox"/> Jet <input type="checkbox"/> Reciprocating <input type="checkbox"/> Centrifugal <input type="checkbox"/> Other

16 Remarks: elevation Topography: <input type="checkbox"/> Hill <input checked="" type="checkbox"/> Slope <input type="checkbox"/> Upland <input type="checkbox"/> Valley	Drilling Sub-contracted to: Minter-Wilson Drilling Co. License #208 Garden City, Kansas 67846 * Lakewood - Slot - .125 X 66 Set between 340' & 430' and 470' & 510'
--	--

17 Water well contractor's certification: This well was drilled under my jurisdiction and this report is true to the best of my knowledge and belief. K. I. Drilling Co., Inc. 263 Business name License No. Address Box 669, Ulysses, Kan. Signed Bob Faulkner date 11-19-75 Authorized representative

29 35W 35 SWSWNE