

## CORRECTION TO WATER WELL RECORD (WWC-5)

The following correction(s) was made to the attached WWC-5 log, in order to file the item or to rectify lacking or incorrect information.

**Fraction ( 1/4 1/4 1/4) Section-Township-Range changed:**

listed as \_\_\_\_\_, sec. 2, T 29S, R 36W

changed to NE, NW, sec. 2, T 29S, R 36W

**Other changes made:**

Initial statements: \_\_\_\_\_

Changed to: \_\_\_\_\_

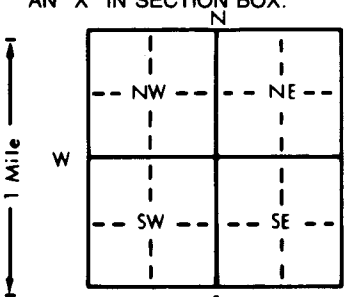
verification method: Location town of Hickok on  
Hickok 1:24,000 Topographic Map initials: ARd date: 11/18/98

submitted by: Kansas Geological Survey, Data Resources Library, 1930 Constant Ave., Lawrence, KS 66047-3726  
to: Kansas Dept of Health & Environment Bureau of Water Industrial Programs, Bldg 283, Forbes Field, KS 66620

1 LOCATION OF WATER WELL: Fraction  $\frac{1}{4}$   $\frac{1}{4}$   $\frac{1}{4}$  Section Number **2** Township Number T **29** S Range Number R **36** EW

Distance and direction from nearest town or city street address of well if located within city?  
**TOWN OF HICKOCK**

2 WATER WELL OWNER: **MINIER WILSON** "EDITH REEVES"  
 RR#, St. Address, Box # : **W. HWY 50** Board of Agriculture, Division of Water Resources  
 City, State, ZIP Code : **GARDEN CITY, KS 67846** Application Number:

3 LOCATE WELL'S LOCATION WITH AN "X" IN SECTION BOX:  DEPTH OF COMPLETED WELL: **360** ft. ELEVATION: \_\_\_\_\_  
 Depth(s) Groundwater Encountered 1. **230** ft. 2. \_\_\_\_\_ ft. 3. \_\_\_\_\_ ft.  
 WELL'S STATIC WATER LEVEL **230** ft. below land surface measured on mo/day/yr **08-22-95**  
 Pump test data: Well water was **250** ft. after **1** hours pumping **15** gpm  
 Est. Yield **15** gpm: Well water was \_\_\_\_\_ ft. after \_\_\_\_\_ hours pumping \_\_\_\_\_ gpm  
 Bore Hole Diameter **9 1/2** in. to **360** ft., and \_\_\_\_\_ in. to \_\_\_\_\_ ft.  
 WELL WATER TO BE USED AS: 5 Public water supply 8 Air conditioning 11 Injection well  
 Domestic 3 Feedlot 6 Oil field water supply 9 Dewatering 12 Other (Specify below)  
 Irrigation 4 Industrial 7 Lawn and garden only 10 Monitoring well  
 Was a chemical/bacteriological sample submitted to Department? Yes \_\_\_\_\_ No  X; If yes, mo/day/yr sample was submitted \_\_\_\_\_  
 Water Well Disinfected? Yes  X No

5 TYPE OF BLANK CASING USED: 5 Wrought iron 8 Concrete tile CASING JOINTS: Glued  X Clamped \_\_\_\_\_  
 1 Steel 3 RMP (SR) 6 Asbestos-Cement 9 Other (specify below) Welded \_\_\_\_\_  
 2 PVC 4 ABS 7 Fiberglass Threaded \_\_\_\_\_  
 Blank casing diameter **5** in. to **360** ft., Dia \_\_\_\_\_ in. to \_\_\_\_\_ ft., Dia \_\_\_\_\_ in. to \_\_\_\_\_ ft.  
 Casing height above land surface **24** in., weight **2.902** lbs./ft. Wall thickness or gauge No. **280 SDR 21**  
 TYPE OF SCREEN OR PERFORATION MATERIAL:  7 PVC 10 Asbestos-cement  
 1 Steel 3 Stainless steel 5 Fiberglass 8 RMP (SR) 11 Other (specify) \_\_\_\_\_  
 2 Brass 4 Galvanized steel 6 Concrete tile 9 ABS 12 None used (open hole)  
 SCREEN OR PERFORATION OPENINGS ARE: 5 Gauzed wrapped  8 Saw cut 11 None (open hole)  
 1 Continuous slot 3 Mill slot 6 Wire wrapped 9 Drilled holes  
 2 Louvered shutter 4 Key punched 7 Torch cut 10 Other (specify) \_\_\_\_\_  
 SCREEN-PERFORATED INTERVALS: From **300** ft. to **360** ft., From \_\_\_\_\_ ft. to \_\_\_\_\_ ft.  
 From \_\_\_\_\_ ft. to \_\_\_\_\_ ft., From \_\_\_\_\_ ft. to \_\_\_\_\_ ft.  
 GRAVEL PACK INTERVALS: From **200** ft. to **360** ft., From \_\_\_\_\_ ft. to \_\_\_\_\_ ft.  
 From \_\_\_\_\_ ft. to \_\_\_\_\_ ft., From \_\_\_\_\_ ft. to \_\_\_\_\_ ft.

6 GROUT MATERIAL:  1 Neat cement 2 Cement grout 3 Bentonite  4 Other **hole plug**  
 Grout Intervals: From **0** ft. to **16** ft., From \_\_\_\_\_ ft. to \_\_\_\_\_ ft., From \_\_\_\_\_ ft. to \_\_\_\_\_ ft.  
 What is the nearest source of possible contamination:  
 1 Septic tank 4 Lateral lines 7 Pit privy 10 Livestock pens 14 Abandoned water well  
 2 Sewer lines 5 Cess pool 8 Sewage lagoon 11 Fuel storage 15 Oil well/Gas well  
 3 Watertight sewer lines 6 Seepage pit 9 Feedyard 12 Fertilizer storage 16 Other (specify below)  
 13 Insecticide storage \_\_\_\_\_  
 Direction from well? \_\_\_\_\_ How many feet? \_\_\_\_\_

FROM	TO	LITHOLOGIC LOG	FROM	TO	PLUGGING INTERVALS
0	6	CLAY			
6	37	SANDY CLAY			
37	83	SAND & GRAVEL			
83	102	CLAY W/GRAVEL STREAKS			
102	112	SANDY CLAY			
112	176	SANDY CLAY W/CLAY			
176	285	BLUE CLAY			
285	299	BROWN CLAY & BLUE CLAY			
299	327	SANDY CLAY & SAND			
327	352	COARSE SAND & GRAVEL			
352	360	CLAY & GRAVEL STREAKS			

7 CONTRACTOR'S OR LANDOWNER'S CERTIFICATION: This water well was  (1) constructed, (2) reconstructed, or (3) plugged under my jurisdiction and was completed on (mo/day/year) **08-22-95** and this record is true to the best of my knowledge and belief. Kansas Water Well Contractor's License No. **KWCL-430** This Water Well Record was completed on (mo/day/yr) **08-22-95** under the business name of **HOWARD DRUG CO. BOX 806 BEAVER, OK 73932** by (signature) \_\_\_\_\_

OFFICE USE ONLY  
T  
R  
EW  
SEC.  
1/4  
1/4  
1/4