


WATER WELL RECORD Form WWC-5 KSA 82a-1212

1 LOCATION OF WATER WELL: County: GRANT Fraction: NE 1/4 SW 1/4 SW 1/4 Section Number: 7 Township Number: T 29 S Range Number: R 36 EW

Distance and direction from nearest town or city street address of well if located within city?
Ulysses - 3 mi East on Hwy 160 - 1 1/4 mi South & East

2 WATER WELL OWNER: GUADALUPE HERNANDEZ ULYSSES, KAN.
 RR#, St. Address, Box #: 10 Minter-Wilson Dr. Co. Box 669
 City, State, ZIP Code: 67980 Board of Agriculture, Division of Water Resources Application Number:

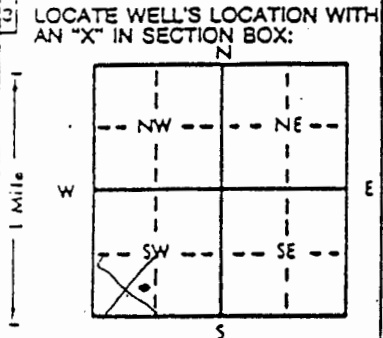

4 DEPTH OF COMPLETED WELL: 320 ft. ELEVATION:
 Depth(s) Groundwater Encountered 1. ft. 2. ft. 3. ft.
 WELL'S STATIC WATER LEVEL ft. below land surface measured on mo/day/yr
 Pump test data: Well water was ft. after hours pumping gpm
 Est. Yield gpm: Well water was ft. after hours pumping gpm
 Bore Hole Diameter: 12 1/4 in. to ft., and 9 1/4 in. to 320 ft.
 WELL WATER TO BE USED AS:
 1 Domestic 3 Feedlot 6 Oil field water supply 9 Dewatering 12 Other (Specify below)
 2 Irrigation 4 Industrial 7 Lawn and garden only 10 Observation well
 Was a chemical/bacteriological sample submitted to Department? Yes.....No If yes, mo/day/yr sample was submitted
 Water Well Disinfected? Yes No

5 TYPE OF BLANK CASING USED:
 1 Steel 3 RMP (SR) 5 Wrought iron 8 Concrete tile CASING JOINTS: Glued Clamped
 2 PVC 4 ABS 6 Asbestos-Cement 9 Other (specify below) Welded
 7 Fiberglass Threaded
 Blank casing diameter: 5.5 in. to 280 ft., Dia. in. to ft., Dia. in. to ft.
 Casing height above land surface: 30 in., weight 5DR-21 0-240' lbs./ft. Wall thickness or gauge No. 5DR-17
 TYPE OF SCREEN OR PERFORATION MATERIAL:
 1 Steel 3 Stainless steel 5 Fiberglass 8 RMP (SR) 11 Other (specify) 240' to 320'
 2 Brass 4 Galvanized steel 6 Concrete tile 9 ABS 12 None used (open hole)
 SCREEN OR PERFORATION OPENINGS ARE:
 1 Continuous slot 3 Mill slot .032
 2 Louvered shutter 4 Key punched
 SCREEN-PERFORATED INTERVALS: From 280 ft. to 320 ft., From ft. to ft.
 GRAVEL PACK INTERVALS: From 200 ft. to 320 ft., From ft. to ft.

6 GROUT MATERIAL: 1 Neat cement 2 Cement grout 3 Bentonite 4 Other
 Grout intervals: From 4 ft. to 15 ft., From 15 ft. to 18 ft., From ft. to ft.
 What is the nearest source of possible contamination: NONE
 1 Septic tank 4 Lateral lines 7 Pit privy 10 Livestock pens 14 Abandoned water well
 2 Sewer lines 5 Cess pool 8 Sewage lagoon 11 Fuel storage 15 Oil well/Gas well
 3 Watertight sewer lines 6 Seepage pit 9 Feedyard 12 Fertilizer storage 16 Other (specify below)
 13 Insecticide storage
 Direction from well? How many feet?

FROM	TO	LITHOLOGIC LOG	FROM	TO	LITHOLOGIC LOG
0	2	Top Soil			
2	16	SAND & CALICHE			
16	24	BROWN CLAY			
24	34	SAND w/ TAN SANDY CLAY STREAKS			
34	78	TAN CLAY			
78	104	TAN SANDY CLAY			
104	143	BLUE-WHITE & YELLOW CLAY w/ SAND			
143	178	YELLOW CLAY			
178	216	TAN CLAY			
216	241	TAN SANDY CLAY			
241	264	SAND w/ TAN SANDY CLAY STREAKS			
264	278	TAN SANDY CLAY			
278	294	COARSE SAND			
294	317	YELLOW CLAY			
317	320	BLACK CLAY			

CONTRACTOR'S OR LANDOWNER'S CERTIFICATION: This water well was (1) constructed (2) reconstructed, or (3) plugged under my jurisdiction and completed on (mo/day/yr) 10-23-96 and this record is true to the best of my knowledge and belief. Kansas Water Well Contractor's License No. 600A This Water Well Record was completed on (mo/day/yr) 10-30-96 under the business name of CRAMER DRG. CO. by (signature) Ray Cramer

INSTRUCTIONS: Use typewriter or ball point pen, PLEASE PRESS FIRMLY and PRINT clearly. Please fill in blanks, underline or circle the correct answers. Send top three copies to Kansas Department of Health and Environment, Division of Environment, Environmental Geology Section, Topeka, KS 66620. Send one to WATER WELL OWNER and retain one for your records.

