


1 LOCATION OF WATER WELL: Fraction SE 1/4 SE 1/4 SW 1/4 Section Number 19 Township Number T 29S S Range Number R 36W EW

Distance and direction from nearest town or city street address of well if located within city?

2 WATER WELL OWNER: MINTER - WILSON DRILLING CO.
 RR#, St. Address, Box #: W - HIWAY 50 Board of Agriculture, Division of Water Resources
 City, State, ZIP Code: GARDEN CITY, KS 67846 Application Number:

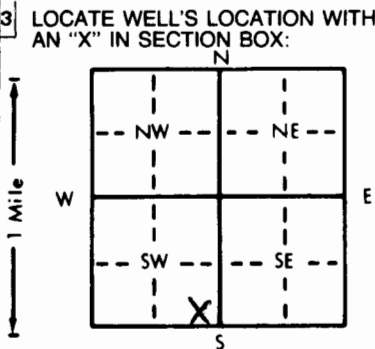

4 DEPTH OF COMPLETED WELL: 460 ft. ELEVATION: ...
 Depth(s) Groundwater Encountered 1. 240 ft. 2. ... ft. 3. ... ft.
 WELL'S STATIC WATER LEVEL: 240 ft. below land surface measured on mo/day/yr 11-11-93
 Pump test data: Well water was 260 ft. after 1 hours pumping 65 gpm
 Est. Yield 65 gpm: Well water was ... ft. after ... hours pumping ... gpm
 Bore Hole Diameter: 9 1/2 in. to 460 ft., and ... in. to ... ft.
 WELL WATER TO BE USED AS:
 1 Domestic 3 Feedlot 6 Oil field water supply 9 Dewatering 12 Other (Specify below)
 2 Irrigation 4 Industrial 7 Lawn and garden only 10 Monitoring well
 Was a chemical/bacteriological sample submitted to Department? Yes ... No ... X ...; If yes, mo/day/yr sample was submitted
 Water Well Disinfected? Yes X No

5 TYPE OF BLANK CASING USED:
 1 Steel 3 RMP (SR) 5 Wrought iron 8 Concrete tile CASING JOINTS: Glued X Clamped
 2 PVC 4 ABS 6 Asbestos-Cement 9 Other (specify below) Welded
 7 Fiberglass Threaded
 Blank casing diameter 5 in. to 460 ft., Dia ... in. to ... ft., Dia ... in. to ... ft.
 Casing height above land surface 24 in., weight 2.902 lbs./ft. Wall thickness or gauge No. 280 SDR 21
 TYPE OF SCREEN OR PERFORATION MATERIAL:
 1 Steel 3 Stainless steel 5 Fiberglass 8 RMP (SR) 10 Asbestos-cement
 2 Brass 4 Galvanized steel 6 Concrete tile 9 ABS 11 Other (specify)
 12 None used (open hole)
 SCREEN OR PERFORATION OPENINGS ARE:
 1 Continuous slot 3 Mill slot 5 Gauzed wrapped 8 Saw cut 11 None (open hole)
 2 Louvered shutter 4 Key punched 6 Wire wrapped 9 Drilled holes
 7 Torch cut 10 Other (specify)
 SCREEN-PERFORATED INTERVALS: From 400 ft. to 460 ft., From ... ft. to ... ft.
 GRAVEL PACK INTERVALS: From 390 ft. to 460 ft., From ... ft. to ... ft.

6 GROUT MATERIAL: 1 Neat cement 2 Cement grout 3 Bentonite 4 Other hole plug
 Grout Intervals: From 1 ft. to 20 ft., From ... ft. to ... ft., From ... ft. to ... ft.
 What is the nearest source of possible contamination:
 1 Septic tank 4 Lateral lines 7 Pit privy 10 Livestock pens 14 Abandoned water well
 2 Sewer lines 5 Cess pool 8 Sewage lagoon 11 Fuel storage 15 Oil well/Gas well
 3 Watertight sewer lines 6 Seepage pit 9 Feedyard 12 Fertilizer storage 16 Other (specify below)
 13 Insecticide storage
 Direction from well? How many feet?

FROM	TO	LITHOLOGIC LOG	FROM	TO	PLUGGING INTERVALS
0	10	TOP SOIL			
10	180	SANDY CLAY TAN			
180	255	BLUE CLAY			
255	283	SANDY CLAY TAN			
283	328	FINE TO COARSE SAND STREAKS OF CLAY AT 300-305			
328	390	SANDY CLAY			
390	450	COARSE SAND & GRAVEL			
450	460	GOLD CLAY			

7 CONTRACTOR'S OR LANDOWNER'S CERTIFICATION: This water well was (1) constructed, (2) reconstructed, or (3) plugged under my jurisdiction and was completed on (mo/day/year) 11-11-93 and this record is true to the best of my knowledge and belief. Kansas Water Well Contractor's License No. KWWCL-430 This Water Well Record was completed on (mo/day/yr) 11-11-93 under the business name of HOWARD DRLG.CO.BOX 806 BEAVER, OK 73932 by (signature)

INSTRUCTIONS: Use typewriter or ball point pen. PLEASE PRESS FIRMLY and PRINT clearly. Please fill in blanks, underline or circle the correct answers. Send top three copies to Kansas Department of Health and Environment, Bureau of Water, Topeka, Kansas 66620-0001. Telephone: 913-296-5545. Send one to WATER WELL OWNER and retain one for your records.