


1 LOCATION OF WATER WELL: County: Grant	Fraction ¼ SE ¼ SE ¼ NE ¼	Section Number 25	Township No. T 29 S	Range Number R 36 <input type="checkbox"/> E <input checked="" type="checkbox"/> W
---	------------------------------	----------------------	------------------------	---

Street/Rural Address of Well Location; if unknown, distance & direction from nearest town or intersection: If at owner's address, check here .
6 East 5 South of Ulysses

Global Positioning System (GPS) information:
Latitude: 37.4969 (in decimal degrees)
Longitude: 101.1990 (in decimal degrees)
Elevation:
Datum: WGS 84, NAD 83, NAD 27
Collection Method:
 GPS unit (Make/Model: Garmin)
 Digital Map/Photo, Topographic Map, Land Survey
Est. Accuracy: <3 m, 3-5 m, 5-15 m, >15 m

2 WATER WELL OWNER: Dennis Devoe *Devoe*
RR#, Street Address, Box #: 8173 E Rd 17
City, State, ZIP Code : Ulysses, KS 67880

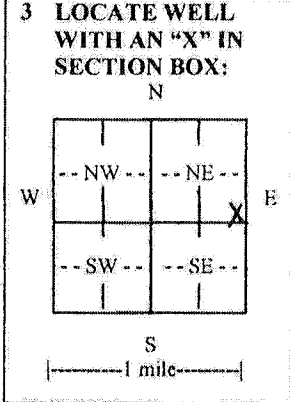

4 DEPTH OF COMPLETED WELL 560 ft.
Depth(s) Groundwater Encountered (1)..... ft. (2)..... ft. (3)..... ft.
WELL'S STATIC WATER LEVEL.....ft. below land surface measured on mo/day/yr.....
Pump test data: Well water was.....ft. after..... hours pumping..... gpm
EST. YIELD.....gpm. Well water was.....ft. after..... hours pumping..... gpm
Bore Hole Diameter 26.....in. toft., andin. toft.
WELL WATER TO BE USED AS: Public water supply Geothermal Injection well
 Domestic Feedlot Oil field water supply Dewatering Other (Specify below)
 Irrigation Industrial Domestic-lawn & garden Monitoring well
Was a chemical/bacteriological sample submitted to Department? Yes No
If yes, mo/day/yr sample was submitted.....
Water well disinfected? Yes No


5 TYPE OF CASING USED: Steel PVC Other
CASING JOINTS: Glued Clamped Welded Threaded
Casing diameter .16..... in. to 560..... ft., Diameter in. to ft., Diameter in. to ft.
Casing height above land surface .12..... in., Weightlbs./ft., Wall thickness or gauge No. 0.25.....
TYPE OF SCREEN OR PERFORATION MATERIAL:
 Steel Stainless Steel PVC Other (Specify)
 Brass Galvanized Steel None used (open hole)
SCREEN OR PERFORATION OPENINGS ARE:
 Continuous slot Mill slot Gauze wrapped Torch cut Drilled holes None (open hole)
 Louvered shutter Key punched Wire wrapped Saw cut Other (specify)
SCREEN-PERFORATED INTERVALS: From 380..... ft. to 480..... ft., From mill 480..... ft. to 560..... ft.
From..... ft. to ft., From..... ft. to ft.
GRAVEL PACK INTERVALS: From 20..... ft. to 560..... ft., From..... ft. to ft.
From..... ft. to ft., From..... ft. to ft.

6 GROUT MATERIAL: Neat cement Cement grout Bentonite Other
Grout Intervals: From 0..... ft. to 20..... ft., From..... ft. to ft., From..... ft. to ft.
What is the nearest source of possible contamination:
 Septic tank Lateral lines Pit privy Livestock pens Insecticide storage Other (specify below)
 Sewer lines Cesspool Sewage lagoon Fuel storage Abandoned water well
 Watertight sewer lines Seepage pit Feedyard Fertilizer storage Oil well/gas well
Direction from well South East Distance from well 150'

FROM	TO	LITHOLOGIC LOG	FROM	TO	LITHO. LOG (cont.) or PLUGGING INTERVALS
		See Attached			

7 CONTRACTOR'S OR LANDOWNER'S CERTIFICATION: This water well was constructed, reconstructed, or plugged under my jurisdiction and was completed on (mo/day/year) 3-10-12 and this record is true to the best of my knowledge and belief. Kansas Water Well Contractor's License No. 473. This Water Well Record was completed on (mo/day/year) 3-28-12 under the business name of Tyler Water Well Inc. by (signature) *[Signature]*

INSTRUCTIONS: Use typewriter or ball point pen. PLEASE PRESS FIRMLY and PRINT clearly. Please fill in blanks and check the correct answers. Send three copies (white, blue, pink) to Kansas Department of Health and Environment, Bureau of Water, Geology Section, 1000 SW Jackson St., Suite 420, Topeka, Kansas 66612-1367. Telephone 785-296-5524. Send one copy to WATER WELL OWNER and retain one for your records. Include fee of \$5.00 for each constructed well. Visit us at <http://www.kdheks.gov/waterwell/index.html>.

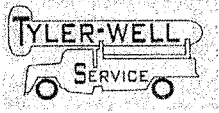

Tyler Water Well Inc.
305 Santa Fe Ave.
Holcomb, KS 67851

TEST HOLE REPORT

Contact Name Dennis Deyeo Date 9-13-11
 Test Hole Number 1 GPS N 37^ 29.811' W 101^ 11.940 Elv 3009
 City Uysses State KS Driller Clint
 Test Hole Location _____
Distance and Direction from Permanent Landmark or Previous Test Hole

TEST LOG

Approximate Static Water Level 340 Measured

FROM	TO	FORMATION	FAIR	GOOD	FROM	TO	FORMATION	FAIR	Good
0	5	Topsoil & Cliché			440	460	Sand & Gravel Little Clay		17
5	20	Fine Sand Little Cliche			460	470	Same		6
20	40	Sand & Gravel			470	480	Cemented Sand & Yellow Clay	5	
40	46	Same			480	500	Yellow Clay & Sandstone	8	
46	58	Brown Clay			500	510	Same	3	
58	60	Fine Sand			510	520	Shale		
60	80	Brown Clay			520	540	Sand & Shale Streaks	10	
80	100	Same			540	560	Sand Clay & Soapstone Green	9	
100	120	Same					& Sandstone		
120	140	Same			560	570	Same	2	
140	160	Same			570	580	Red Bed		
160	180	Gray Clay							
180	200	Brown & Gray Clay Lt Cavy							
200	220	Same							
220	226	Same							
226	240	Sand & Clay Mix							
240	245	Same							
245	260	Brown Clay							
260	280	Brown Clay & Cliché							
280	300	Clay & Sand Streaks							
300	310	Sandy Clay & Cliché							
310	320	Sand Little Clay							
320	340	Gravel Little Clay							
340	360	Fine Sand Loose	17						
360	380	Fine to Medium Sand Little							
		Cliché & Cavy Clay	15						
380	400	Sand Fine to Medium Little							
		Cliché	17						
400	420	Loose Brown Rock & Sand		18					
420	440	Sand Medium to Coarse Little							
		Clay		18					

Bags of Mud 5
 Bags of Hole Plug 3
 Bit Yes _____ No X

Bags of Bran _____
 Macro Fill _____
 Bags of Cotton Seed _____