


1 LOCATION OF WATER WELL: County: **GRANT** Fraction: **NW 1/4 NE 1/4 SW 1/4** Section Number: **5** Township Number: **T 29 S** Range Number: **R 37W E/W**

Distance and direction from nearest town or city street address of well if located within city?  
**FROM ULYSSES: 2 SOUTH, 2 WEST, .5 NORTH, .3 EAST & SOUTH INTO LOC.**

2 WATER WELL OWNER: **WEBBER SUPPLY**  
 RR#, St. Address, Box #: **HWY 60 W, 2718 W OKLA.** Board of Agriculture, Division of Water Resources  
 City, State, ZIP Code: **ULYSSES, KS, 67880** Application Number:

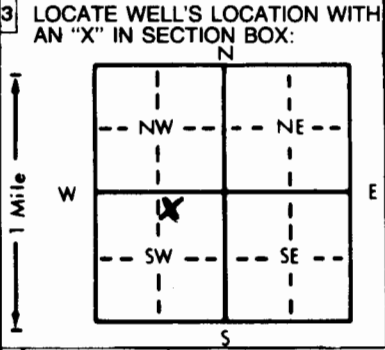

4 DEPTH OF COMPLETED WELL: **460** ft. ELEVATION:  
 Depth(s) Groundwater Encountered 1. **240** ft. 2. ft. 3. ft.  
 WELL'S STATIC WATER LEVEL: **240** ft. below land surface measured on mo/day/yr **03-27-96**  
 Pump test data: Well water was **260** ft. after **1** hours pumping **70** gpm  
 Est. Yield **70** gpm: Well water was ft. after hours pumping gpm  
 Bore Hole Diameter: in. to ft., and in. to ft.  
 WELL WATER TO BE USED AS:  
 1 Domestic  3 Feedlot  6 Oil field water supply  9 Dewatering  12 Other (Specify below)  
 2 Irrigation  4 Industrial  7 Lawn and garden only  10 Monitoring well  
 Was a chemical/bacteriological sample submitted to Department? Yes.....No..... X; If yes, mo/day/yr sample was submitted  
 Water Well Disinfected? Yes  X No

5 TYPE OF BLANK CASING USED:  
 1 Steel  3 RMP (SR)  6 Asbestos-Cement  9 Other (specify below)  Welded  
 2 PVC  4 ABS  7 Fiberglass  Threaded  
 Blank casing diameter: **9 1/2** in. to **460** ft., Dia. in. to ft., Dia. in. to ft.  
 Casing height above land surface: **24** in., weight **2.902** lbs./ft. Wall thickness or gauge No. **.280 SDR 21**  
 TYPE OF SCREEN OR PERFORATION MATERIAL:  
 1 Steel  3 Stainless steel  5 Fiberglass  8 RMP (SR)  11 Other (specify)  
 2 Brass  4 Galvanized steel  6 Concrete tile  9 ABS  12 None used (open hole)  
 SCREEN OR PERFORATION OPENINGS ARE:  
 1 Continuous slot  3 Mill slot  6 Wire wrapped  9 Drilled holes  
 2 Louvered shutter  4 Key punched  7 Torch cut  10 Other (specify)  
 8 Saw cut  11 None (open hole)  
 SCREEN-PERFORATED INTERVALS: From **320** ft. to **400** ft., From ft. to ft.  
 GRAVEL PACK INTERVALS: From **220** ft. to **420** ft., From ft. to ft.

6 GROUT MATERIAL:  1 Neat cement  2 Cement grout  3 Bentonite  4 Other **HOLE PLUG**  
 Grout Intervals: From **0** ft. to **16** ft., From ft. to ft., From ft. to ft.  
 What is the nearest source of possible contamination:  
 1 Septic tank  4 Lateral lines  7 Pit privy  10 Livestock pens  14 Abandoned water well  
 2 Sewer lines  5 Cess pool  8 Sewage lagoon  11 Fuel storage  15 Oil well/Gas well  
 3 Watertight sewer lines  6 Seepage pit  9 Feedyard  12 Fertilizer storage  16 Other (specify below)  
 13 Insecticide storage  
 Direction from well? How many feet?

FROM	TO	LITHOLOGIC LOG	FROM	TO	PLUGGING INTERVALS
0	2	TOP SOIL & CLAY	257	261	CLAY
2	14	CLAY	261	278	COARSE SAND
14	20	COARSE SAND	278	291	SANDY CLAY & CLAY
20	41	CLAY	291	302	CLAY
41	65	SANDY CLAY & CLAY	302	319	SANDY CLAY & SAND
65	82	CLAY	319	335	SAND
82	97	SANDY CLAY & CLAY	335	346	CLAY
97	118	SAND	346	359	SANDY CLAY & SAND
118	133	SAND & CLAY STREAKS	359	371	COARSE SAND
133	176	CLAY	371	380	BLACK CLAY & SANDY CLAY
176	185	CLAY & SANDY CLAY	380	437	BLACK CLAY
185	224	SANDY CLAY	437	460	BLACK & YELLOW & WHITE CLAY
224	236	COARSE SAND W/CLAY STREAKS			
236	240	CLAY			
240	257	COARSE SAND W/CLAY STREAKS			

7 CONTRACTOR'S OR LANDOWNER'S CERTIFICATION: This water well was  (1) constructed,  (2) reconstructed, or  (3) plugged under my jurisdiction and was completed on (mo/day/year) **03-27-96** and this record is true to the best of my knowledge and belief. Kansas Water Well Contractor's License No. **KWACL-430**. This Water Well Record was completed on (mo/day/yr) **03-27-96** under the business name of **HOWARD DRUG CO. BOX 806 BEAVER, OK 73932** by (signature) *Howard Drug Co.*

INSTRUCTIONS: Use typewriter or ball point pen. PLEASE PRESS FIRMLY and PRINT clearly. Please fill in blanks, underline or circle the correct answers. Send top three copies to Kansas Department of Health and Environment, Bureau of Water, Topeka, Kansas 66620-0001. Telephone: 913-296-5545. Send one to WATER WELL OWNER and retain one for your records.

22765