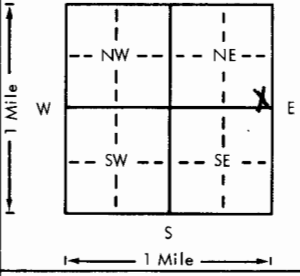


USE TYPEWRITER OR BALL POINT PEN—PRESS FIRMLY, PRINT CLEARLY.

WATER WELL RECORD
KSA 82a-1201-1215

Kansas Department of Health and Environment—Division of Environment (Water well Contractors) Topeka, Kansas 66620

1. Location of well:		County Grant	Fraction SE 1/4 SE 1/4 NE 1/4	Section number 6	Township number T 29 S	Range number R 37 E W
2. Distance and direction from nearest town or city: 2 west and 1 3/4 south of four way stop at Ulysses Street address of well location if in city:			3. Owner of well: Danny Hassett R.R. or street: Ulysses, Ks. 67880 City, state, zip code:			
4. Locate with "X" in section below: N  W E S 1 Mile			Sketch map:			6. Bore hole dia. <u>9 1/2</u> in. Completion date _____ Well depth <u>403 1/2</u> ft. <u>4/27/78</u>
5. Type and color of material			From	To	7. <input checked="" type="checkbox"/> Cable tool <input checked="" type="checkbox"/> Rotary <input type="checkbox"/> Driven <input type="checkbox"/> Dug <input type="checkbox"/> Hollow rod <input type="checkbox"/> Jetted <input type="checkbox"/> Bored <input type="checkbox"/> Reverse rotary	
Surface			0	2	8. Use: <input checked="" type="checkbox"/> Domestic <input type="checkbox"/> Public supply <input type="checkbox"/> Industry <input type="checkbox"/> Irrigation <input type="checkbox"/> Air conditioning <input type="checkbox"/> Stock <input type="checkbox"/> Lawn <input type="checkbox"/> Oil field water <input type="checkbox"/> Other	
Sandy clay			2	9	9. Casing: Material <u>styrene</u> Height <u>18</u> Above or below <u>glued and rivited</u> surface _____ in. Theaded _____ Welded _____ Surface _____ in. RMP _____ PVC _____ Weight _____ lbs./ft. Dia. <u>5</u> in. to <u>363</u> ft. depth Wall Thickness: inches or Dia. _____ in. to _____ ft. depth Gage No. <u>.320</u>	
Sand			9	17	10. Screen: Manufacturer's name _____ Sunflower Type <u>styrene</u> Dia. <u>5"</u> Slot/gauze <u>1/16"</u> Length <u>40</u> Set between <u>363</u> ft. and <u>403</u> ft. _____ ft. and _____ ft. Gravel pack? <input checked="" type="checkbox"/> Size range of material <u>1/4"</u>	
Brown sandy clay w/sand strips			17	69	11. Static water level: _____ mo./day/yr. <u>150</u> ft. below land surface Date <u>4/27/78</u>	
Brown clay			69	116	12. Pumping level below land surfaces: <u>160</u> ft. after <u>8</u> hrs. pumping <u>20</u> g.p.m. _____ ft. after _____ hrs. pumping _____ g.p.m. Estimated maximum yield _____ <u>50</u> g.p.m.	
Blue clay			116	153	13. Water sample submitted: _____ mo./day/yr. <input type="checkbox"/> Yes <input checked="" type="checkbox"/> No Date _____	
Gray and brown clay			153	187	14. Well head completion: <input checked="" type="checkbox"/> Pitless adapter <u>18</u> Inches above grade	
Fine to coarse sand w/clay breakers 4-8			187	206	15. Well grouted? <input checked="" type="checkbox"/> With: <input checked="" type="checkbox"/> Neat cement <input type="checkbox"/> Bentonite <input type="checkbox"/> Concrete Depth: From <u>0</u> ft. to <u>10</u> ft.	
Brown clay w/embedded sand			206	224	16. Nearest source of possible contamination: <u>field</u> ft. _____ Direction _____ Type _____ Well disinfected upon completion? <input checked="" type="checkbox"/> Yes <input type="checkbox"/> No	
Medium to coarse sand and gravel w/lime shells and clay breakers 12			224	240	17. Pump: <input checked="" type="checkbox"/> Not installed Manufacturer's name _____ Model number _____ HP _____ Volts _____ Length of drop pipe _____ ft. capacity _____ g.p.m. Type: <input type="checkbox"/> Submersible <input type="checkbox"/> Turbine <input type="checkbox"/> Jet <input type="checkbox"/> Reciprocating <input type="checkbox"/> Centrifugal <input type="checkbox"/> Other	
Fine to coarse sand w/clay breakers and lime shells			240	259	20. Water well contractor's certification: This well was drilled under my jurisdiction and this report is true to the best of my knowledge and belief. Houck Bros. Drlg. Co. 164 Business name License No. Address Box 487, Ulysses, Ks. Signed <u>M. Beard</u> Date <u>5/20/78</u> Authorized representative	
Embedded very fine to medium sand w/clay break.			259	273		
Fine to coarse sand w/clay breakers			273	285		
Brown clay embedded sand strips			285	387		
Fine to coarse sand w/clay breakers			387	403		
(Use a second sheet if needed)						
18. Elevation:		19. Remarks: This well was drilled so that a trailer house and barn could be moved in and built				
Topography: <input type="checkbox"/> Hill <input checked="" type="checkbox"/> Slope <input type="checkbox"/> Upland <input type="checkbox"/> Valley						

29 32 W 1/4 SE SE NE