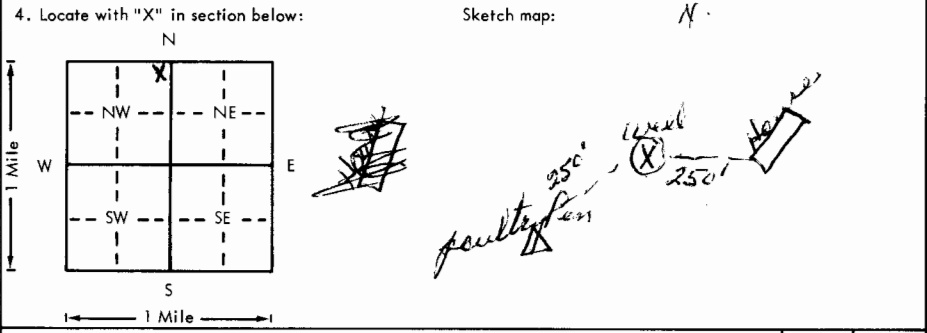


USE TYPEWRITER OR BALL POINT PEN-PRESS FIRMLY, PRINT CLEARLY.

WATER WELL RECORD  
KSA 82a-1201-1215

Kansas Department of Health and Environment-Division of Environment  
(Water well Contractors)  
Topeka, Kansas 66620

1. Location of well:	County <b>Grant</b>	Fraction <b>NE 1/4 NE 1/4 NW 1/4</b>	Section number <b>9</b>	Township number <b>T 29 S R 37 E <sup>W</sup></b>	Range number <b>37</b>
2. Distance and direction from nearest town or city: <b>from the four way stop at Ulysses -- 2 miles south 3/8 mile west</b>			3. Owner of well: <b>Buddy Neatherlin</b> R.R. or street: <b>RFD 3</b> City, state, zip code: <b>Ulysses, Ks. 67880</b>		
4. Locate with "X" in section below: 			6. Bore hole dia. <b>9 1/4</b> in. Completion date _____ Well depth <b>330</b> ft. <b>6/5/78</b>		
5. Type and color of material			7. <input checked="" type="checkbox"/> Cable tool <input checked="" type="checkbox"/> Rotary <input type="checkbox"/> Driven <input type="checkbox"/> Dug <input type="checkbox"/> Hollow rod <input type="checkbox"/> Jetted <input type="checkbox"/> Bored <input type="checkbox"/> Reverse rotary		
Surface			8. Use: <input checked="" type="checkbox"/> Domestic <input type="checkbox"/> Public supply <input type="checkbox"/> Industry <input type="checkbox"/> Irrigation <input type="checkbox"/> Air conditioning <input type="checkbox"/> Stock <input type="checkbox"/> Lawn <input type="checkbox"/> Oil field water <input type="checkbox"/> Other		
Fine sand & sandy clay			9. Casing: Material <b>styrene</b> Height (Above or below) _____ Threaded _____ Welded _____ Surface <b>20</b> in. <b>glued and riveted</b> Weight _____ lbs./ft. Dia. <b>5</b> in. to <b>290</b> ft. depth Wall Thickness _____ inches or Dia. _____ in. to _____ ft. depth Gauge No. <b>.320</b>		
Brown sandy clay w/very fine sand strips			10. Screen: Manufacturer's name _____ <b>Sunflower</b> Type <b>styrene</b> Dia. <b>5"</b> Slot/gauze <b>1/16"</b> Length <b>40'</b> Set between <b>290</b> ft. and <b>330</b> ft. _____ ft. and _____ ft. Gravel pack? <input checked="" type="checkbox"/> Size range of material <b>1/4</b>		
Brown clay			11. Static water level: _____ mo./day/yr. <b>180</b> ft. below land surface Date <b>6/23/78</b>		
Blue gummy clay			12. Pumping level below land surfaces: <b>212</b> ft. after <b>36</b> hrs. pumping <b>20</b> g.p.m. _____ ft. after _____ hrs. pumping _____ g.p.m. Estimated maximum yield <b>25</b> g.p.m.		
Brown sandy clay			13. Water sample submitted: _____ mo./day/yr. <input type="checkbox"/> Yes <input checked="" type="checkbox"/> No Date _____		
Brown sandy clay w/embedded sand strips			14. Well head completion: <input checked="" type="checkbox"/> Pitless adapter <b>20</b> Inches above grade		
Fine to coarse sand gravel w/clay breakers			15. Well grouted? <input checked="" type="checkbox"/> With: <input checked="" type="checkbox"/> Neat cement <input type="checkbox"/> Bentonite <input type="checkbox"/> Concrete Depth: From <b>0</b> ft. to <b>10</b> ft.		
(Use a second sheet if needed)			16. Nearest source of possible contamination: ft. <b>200</b> Direction <b>NE</b> Type <b>septic tank</b> Well disinfected upon completion? <input checked="" type="checkbox"/> Yes <input type="checkbox"/> No		
18. Elevation:			17. Pump: <input checked="" type="checkbox"/> Not installed Manufacturer's name _____ Model number _____ HP _____ Volts _____ Length of drop pipe _____ ft. capacity _____ g.p.m. Type: <input type="checkbox"/> Submersible <input type="checkbox"/> Turbine <input type="checkbox"/> Jet <input type="checkbox"/> Reciprocating <input type="checkbox"/> Centrifugal <input type="checkbox"/> Other		
19. Remarks:			20. Water well contractor's certification: This well was drilled under my jurisdiction and this report is true to the best of my knowledge and belief. <b>Houck Bros. Drlg. Co. 164</b> Business name License No. Address <b>Box 487, Ulysses, Ks.</b> Signed <b>M. Beard</b> Date <b>6/6/78</b> Authorized representative		

T 29 R 37 S 9 NE NE NW 1/4 1/4 1/4