

USE TYPEWRITER OR BALL POINT PEN-PRESS FIRMLY, PRINT CLEARLY.

WATER WELL RECORD
KSA 82a-1201-1215


T R EW sec 1/4 1/4 1/4 No.

Kansas State Dept. Of Health
(Water Well Contractors)
Forbes-Bldg. 740
Topeka, Kansas 66620

1 Location of well:	County Grant	Township name NW 1/4, SW 1/4, NE 1/4	Fraction NW 1/4, SW 1/4, NE 1/4	Section number 35	Town number T29.5	Range number R37W
---------------------	------------------------	--	---	-----------------------------	-----------------------------	-----------------------------

Distance and direction from nearest town or city:
5 South, 1 1/2 East, & 1/4 South of Ulysses
Street address of well location if in city:

3 Owner of well:
Glen Jarvis
Address:
205 North College Ulysses, Kansas 67880

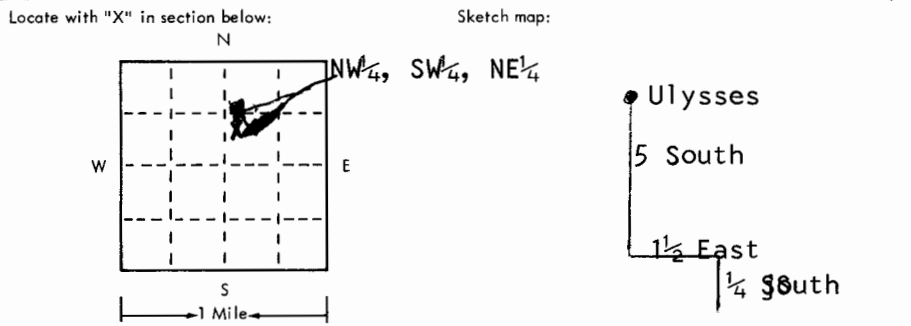

4 Well depth: 530 ft. Date of completion 5/15/75
Well diameter 26 in.

5 Cable tool Rotary Driven Dug
 Hollow rod Jetted Bored Reverse rotary

6 Use: Domestic Public supply Industry
 Irrigation Air conditioning Commercial
 Test well

7 Casing: Material steel Height: above/below
Threaded Welded Surface 12 in.
Diam. 16 in. to 530 ft. depth! Drive shoe? Yes No
16 in. to 530 ft. depth!

2	Type and color of material	From	To
	Surface and Brown Clay	0	15
	Brown Clay-Some Gyp from 60' to 75'	15	210
	Blue Clay and Gyp	210	225
	Blue Clay	225	255
	Coarse Sand and Clay strips- 90%	255	285
	Coarse Sand	285	330
	Medium Sand	330	360
	Brown Sandy Clay- 20%	360	375
	Brown Sandy Clay and Lava Rock- 20 %	375	390
	Brown Sandy Clay and Lava Rock- 30%	390	405
	Brown Clay	405	450
	Brown Clay and some Blue shale	450	480
	Brown Clay, Blue Shale, and Brown Cheyenne	480	525
	Brown Shale and Gray Clay	525	565
	Red Bed	565	570

8 Screen:
Manufacturer Johnson
Type Galvanized Dia. 16 inches
Slot/gauge 100x100 Length 20'
Set between 340 ft. and 360 ft.

* Fittings: See Remarks
Gravel pack Yes No Size range of material 1/2 down

9 Static water level:
295 ft. below land surface Date 5/15/75

10 Pumping level below land surfaces:
390 ft. after 18 hrs. pumping 750 g.p.m.
____ ft. after ____ hrs. pumping ____ g.p.m.
Estimated maximum yield 800 g.p.m.

11 Water sample submitted:
 Yes No Date _____

12 Well head completion:
 Pitless adapter 12 inches above grade

13 Well grouted? Yes No
 Neat cement Bentonite
Depth: From 0 ft. to 10 ft.

14 Nearest source of possible contamination: in field
ft. _____ Direction NONE Type _____
Well disinfected upon completion? Yes No

15 Pump:
 Not installed
Manufacturer's name Peerless
Model number used HP 100 Volts _____
Length of drop pipe 170 ft. capacity 1000 g.p.m.
Type:
 Submersible Turbine
 Jet Reciprocating
 Centrifugal Other

16 Remarks: elevation
K.I. Drilling Sub-Contracted by License NO. #208
Minter Wilson Drilling Co.-Inc. Garden City, Kansas
* Lakewood Perf.- Slot-.125x66
Set between 300' to 340' & 360' to 530'

Topography:
 Hill
 Slope
 Upland
 Valley

17 Water well contractor's certification:
This well was drilled under my jurisdiction and this report is true to the best of my knowledge and belief.
K.I. Drilling #263
Business name License No.
Address Ulysses, Kansas 67880
Signed Bob Fisher Date 5/4/75
Authorized representative