

WATER WELL RECORD Form WWC-5


Division of Water Resources App. No.

Well ID

- Original Record Correction Change in Well Use

1 LOCATION OF WATER WELL: County: Grant Fraction NE 1/4 NE 1/4 NW 1/4 SW 1/4 Section Number 11 Township Number T 29 S Range Number R 37 E W

2 WELL OWNER: Last Name: Rodriquez First: Guadalupe Street or Rural Address where well is located (if unknown, distance and direction from nearest town or intersection): If at owner's address, check here: From intersect E Rd 14 & S Stubbs Rd 1/2 Mile South & 1/4 Mile East

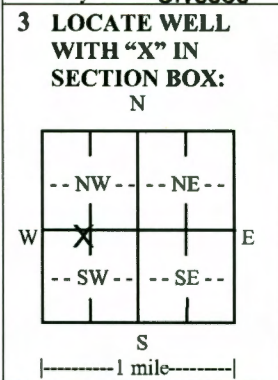

3 LOCATE WELL WITH 'X' IN SECTION BOX: N W E S
4 DEPTH OF COMPLETED WELL: 500 ft. Depth(s) Groundwater Encountered: 1) 282 ft. 2) ft. 3) ft. or 4) Dry Well WELL'S STATIC WATER LEVEL: 282 ft. below land surface, measured on (mo-day-yr) 08/11/2021

5 Latitude: 37.539631 (decimal degrees) Longitude: -101.341410 (decimal degrees) Datum: WGS 84 NAD 83 NAD 27 Source for Latitude/Longitude: GPS (unit make/model) (WAAS enabled? Yes No) Land Survey Topographic Map Online Mapper

6 Elevation: ft. Ground Level TOC Source: Land Survey GPS Topographic Map Other

7 WELL WATER TO BE USED AS: 1. Domestic: Household Lawn & Garden Livestock Irrigation Feedlot Industrial 5. Public Water Supply: well ID 6. Dewatering: how many wells? 7. Aquifer Recharge: well ID 8. Monitoring: well ID 9. Environmental Remediation: well ID Air Sparge Soil Vapor Extraction Recovery Injection 10. Oil Field Water Supply: lease 11. Test Hole: well ID Cased Uncased Geotechnical 12. Geothermal: how many bores? a) Closed Loop Horizontal Vertical b) Open Loop Surface Discharge Inj. of Water 13. Other (specify):

Was a chemical/bacteriological sample submitted to KDHE? Yes No If yes, date sample was submitted: Water well disinfected? Yes No

8 TYPE OF CASING USED: Steel PVC Other CASING JOINTS: Glued Clamped Welded Threaded Casing diameter 6 in. to 500 ft., Diameter in. to ft., Diameter in. to ft. Casing height above land surface 18 in. Weight lbs./ft. Wall thickness or gauge No. SDR17

TYPE OF SCREEN OR PERFORATION MATERIAL: Steel Stainless Steel PVC Other (Specify) Brass Galvanized Steel None used (open hole) SCREEN OR PERFORATION OPENINGS ARE: Continuous Slot Mill Slot Gauze Wrapped Torch Cut Drilled Holes Other (Specify) Louvered Shutter Key Punched Wire Wrapped Saw Cut None (Open Hole) SCREEN-PERFORATED INTERVALS: From 320 ft. to 360 ft., From 380 ft. to 500 ft., From ft. to ft. GRAVEL PACK INTERVALS: From 0 ft. to 5 ft., From 70 ft. to 500 ft., From ft. to ft.

9 GROUT MATERIAL: Neat cement Cement grout Bentonite Other Grout Intervals: From 5 ft. to 70 ft., From ft. to ft., From ft. to ft. Nearest source of possible contamination: No potential source of contamination within 200 ft. Septic Tank Lateral Lines Pit Privy Livestock Pens Insecticide Storage Sewer Lines Cess Pool Sewage Lagoon Fuel Storage Abandoned Water Well Watertight Sewer Lines Seepage Pit Feedyard Fertilizer Storage Oil Well/Gas Well Other (Specify) Nothing w/in. 300' Direction from well? Distance from well? ft.

Table with 6 columns: 10 FROM, TO, LITHOLOGIC LOG, FROM, TO, LITHO. LOG (cont.) or PLUGGING INTERVALS

Notes:

11 CONTRACTOR'S OR LANDOWNER'S CERTIFICATION: This water well was constructed, reconstructed, or plugged under my jurisdiction and was completed on (mo-day-year) 08/11/2021 and this record is true to the best of my knowledge and belief. Kansas Water Well Contractor's License No. 846 This Water Well Record was completed on (mo-day-year) 08/30/2021 under the business name of Nash Water Well Service, LLC

Form	WWC5
Contractor	Nash Water Well Service, LLC
Well Owner	Guadalupe Rodriguez
Doc ID	1588597

Lithology

From	To	Lithologic Log
0	22	FINE SAND
22	28	FINE COARSE SAND
28	60	TAN GRAY BLUE CLAY & FINE SAND
60	65	TAN YELLOW CLAY
65	72	TAN BROWN BLUE GRAY CLAY
72	76	TAN CLAY
76	80	FINE MEDIUM SAND
80	120	FINE MEDIUM SAND WITH TAN CLAY STREAKS & LAYER
120	200	TAN CLAY
200	220	TAN WHITE CLAY & CALICHE WITH FINE SAND
220	240	FINE COARSE SAND WITH SMALL TO MEDIUM GRAVEL & THIN TAN CLAY STREAKS
240	260	FINE MEDIUM SAND WITH TAN WHITE CLAY
260	280	TAN CLAY WITH FINE SAND STREAKS
280	330	FINE MEDIUM SAND WITH TAN CLAY STREAKS
330	340	FINE COARSE SAND WITH SMALL MEDIUM GRAVEL
340	350	FINE MEDIUM SAND & TAN CLAY

Form	WWC5
Contractor	Nash Water Well Service, LLC
Well Owner	Guadalupe Rodriguez
Doc ID	1588597

Lithology

From	To	Lithologic Log
350	354	FINE COARSE SAND WITH SMALL MEDIUM GRAVEL
354	380	TAN GRAY CLAY WITH FINE MEDIUM SAND
380	400	BLUE GRAY TAN CLAY WITH FINE SAND STREAKS
400	430	BLUE GRAY CLAY WITH FINE SAND STREAKS
430	470	GRAY SANDSTONE WITH GRAY CLAY
470	473	RED GRAY CLAY
473	480	GRAY CLAY WITH GRAY SANDSTONE
480	495	GRAY SANDSTONE WITH GRAY CLAY
495	500	RED CLAY