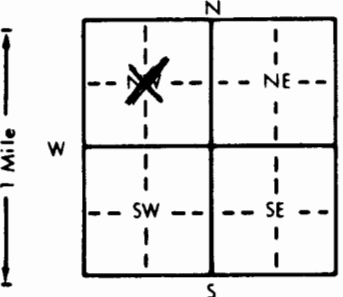


1 LOCATION OF WATER WELL: Fraction  $\frac{1}{4}$   $\frac{1}{4}$  C/NW  $\frac{1}{4}$  Section Number 7 Township Number T 29 S Range Number R 38 **EW**

Distance and direction from nearest town or city street address of well if located within city?  
 FROM 4WAY STOP AT ULYSSES8W, 2 $\frac{1}{2}$ S, & W INTO LOC.

2 WATER WELL OWNER: MINTER-WILSON DRILLING CO.  
 RR#, St. Address, Box #: BOX 669 Board of Agriculture, Division of Water Resources  
 City, State, ZIP Code: ULYSSES, KS 67880 Application Number:

3 LOCATE WELL'S LOCATION WITH AN "X" IN SECTION BOX:  

 4 DEPTH OF COMPLETED WELL: 400 ft. ELEVATION:  
 Depth(s) Groundwater Encountered 1. 265 ft. 2. ft. 3. ft.  
 WELL'S STATIC WATER LEVEL: 265 ft. below land surface measured on mo/day/yr 2-24-94  
 Pump test data: Well water was 270 ft. after 1 hours pumping 90 gpm  
 Est. Yield .90 gpm: Well water was ft. after hours pumping gpm  
 Bore Hole Diameter: 9 $\frac{1}{2}$  in. to 400 ft., and in. to ft.  
 WELL WATER TO BE USED AS:  
 Domestic 3 Feedlot 6 Oil field water supply 9 Dewatering 12 Other (Specify below)  
 Irrigation 4 Industrial 7 Lawn and garden only 10 Monitoring well  
 Was a chemical/bacteriological sample submitted to Department? Yes No  X; If yes, mo/day/yr sample was submitted  
 Water Well Disinfected? Yes  X No

5 TYPE OF BLANK CASING USED:  
 1 Steel 3 RMP (SR) 5 Wrought iron 8 Concrete tile CASING JOINTS: Glued  X Clamped  
 2 PVC 4 ABS 6 Asbestos-Cement 9 Other (specify below) Welded  
 7 Fiberglass Threaded  
 Blank casing diameter 5 in. to 400 ft., Dia in. to ft., Dia in. to ft.  
 Casing height above land surface 24 in., weight 2.902 lbs./ft. Wall thickness or gauge No. 265 SDR 21  
 TYPE OF SCREEN OR PERFORATION MATERIAL:  
 1 Steel 3 Stainless steel 5 Fiberglass 8 RMP (SR) 10 Asbestos-cement  
 2 Brass 4 Galvanized steel 6 Concrete tile 9 ABS 11 Other (specify)  
 12 None used (open hole)  
 SCREEN OR PERFORATION OPENINGS ARE:  
 1 Continuous slot 3 Mill slot 5 Gauzed wrapped 8 Saw cut 11 None (open hole)  
 2 Louvered shutter 4 Key punched 6 Wire wrapped 9 Drilled holes  
 7 Torch cut 10 Other (specify)  
 SCREEN-PERFORATED INTERVALS: From 340 ft. to 400 ft. From ft. to ft.  
 From ft. to ft. From ft. to ft.  
 GRAVEL PACK INTERVALS: From 140 ft. to 400 ft. From ft. to ft.  
 From ft. to ft. From ft. to ft.

6 GROUT MATERIAL:  1 Neat cement 2 Cement grout 3 Bentonite  4 Other HOLE PLUG  
 Grout intervals: From 1 ft. to 20 ft. From ft. to ft. From ft. to ft.  
 What is the nearest source of possible contamination:  
 1 Septic tank 4 Lateral lines 7 Pit privy 10 Livestock pens 14 Abandoned water well  
 2 Sewer lines 5 Cess pool 8 Sewage lagoon 11 Fuel storage 15 Oil well/Gas well  
 3 Watertight sewer lines 6 Seepage pit 9 Feedyard 12 Fertilizer storage 16 Other (specify below)  
 13 Insecticide storage  
 Direction from well? How many feet?

FROM	TO	LITHOLOGIC LOG	FROM	TO	PLUGGING INTERVALS
0	3	TOP			
3	152	CLAY			
152	173	SANDY CLAY			
173	194	CLAY			
194	206	SAND			
206	232	SANDY CLAY			
232	362	CLAY			
362	394	SAND			
394	400	CLAY			

7 CONTRACTOR'S OR LANDOWNER'S CERTIFICATION: This water well was  (1) constructed, (2) reconstructed, or (3) plugged under my jurisdiction and was completed on (mo/day/year) 2-24-94 and this record is true to the best of my knowledge and belief. Kansas Water Well Contractor's License No. KWCL-430. This Water Well Record was completed on (mo/day/yr) 2-24-94 under the business name of HOWARD DRIG. CO. BOX 806 BEAVER, OK 73932 by (signature) *Olivia Howard*

INSTRUCTIONS: Use typewriter or ball point pen. PLEASE PRESS FIRMLY and PRINT clearly. Please fill in blanks, underline or circle the correct answers. Send top three copies to Kansas Department of Health and Environment, Bureau of Water, Topeka, Kansas 66620-0001. Telephone: 913-296-5545. Send one to WATER WELL OWNER and retain one for your records.