

USE TYPEWRITER OR BALL POINT PEN-PRESS FIRMLY, PRINT CLEARLY.

T R EW sec 1/4 1/4 1/4 No.


WATER WELL RECORD
KSA 82a-1201-1215

Kansas State Dept. Of Health
(Water Well Contractors)
Forbes-Bldg. 740
Topeka, Kansas 66620

1 Location of well:	County Grant	Township name Sullivan	Fraction NE¹/₄, NW¹/₄, SE¹/₄	Section number 18	Town number T29S	Range number R38W
---------------------	------------------------	----------------------------------	--	-----------------------------	----------------------------	-----------------------------

Distance and direction from nearest town or city:
8 mi. W., 3 mi. S., 1/2 W. & 1/2 S. of Ulysses
Street address of well location if in city:
Kansas

3 Owner of well: **Harry Goertzen**
Address: **Johnson, Kansas 67855**

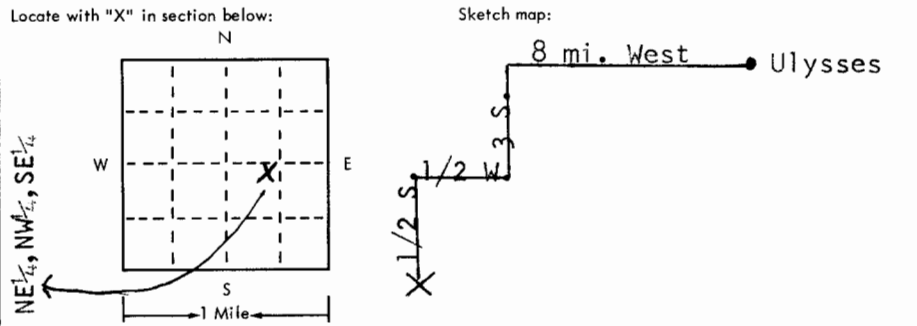

4 Well depth: **480** ft. Date of completion **2-22-75**
Well diameter **26** in.

5 Cable tool Rotary Driven Dug
 Hollow rod Jetted Bored Reverse rotary

6 Use: Domestic Public supply Industry
 Irrigation Air conditioning Commercial
 Test well

7 Casing: Material **Steel** Height: above ~~land~~
Threaded Welded Surface **12** in.
Diam. **16** in. to **480** ft. depth Drive shoe? Yes No
Weight **34 1/2** lbs./ft. No

2	Type and color of material	From	To
	Surface-Dark Sandy Soil to Fine Sand	0	38
	Sticky Brown Clay	38	65
	Medium Sand - Clay Streaks	65	120
	Sandy Clay - Thin Sand Streaks	120	160
	" " Med. " "	160	180
	Light Sand (Loose) with some Pink Clay	180	240
	Sandy Clay - 17' Med. Sand Streaks	240	320
	Coarse Sand - 8' to White Clay	320	340
	Sandy Clay to Heavy Med. Loose Sand	340	360
	Coarse Sand to Small Gravel	360	400
	Sand, Gravel & Sandstone - 3'	400	420
	Sand & Clay Layers	420	440
	Coarse Sand with Clay Strips	440	460
	Sand mixed with Clay (Mostly Clay)	460	480
	Yellow Clay	480	520
	(use a second sheet if needed)		

8 Screen:
Manufacturer **Johnson**
Type **Galvanized** Dia. **16"**
Slot/gouze **100x100** Length **20'**
Set between **370** ft. and **390** ft. **50lb. per Ft.**
*Fittings: **See Remarks**
Gravel pack Yes No Size range of material **1/2** down

9 Static water level:
140 ft. below land surface Date **2-26-75**

10 Pumping level below land surfaces:
240 ft. after **2** hrs. pumping **1350** g.p.m.
____ ft. after ____ hrs. pumping ____ g.p.m.
Estimated maximum yield **1600** g.p.m.

11 Water sample submitted:
 Yes No Date _____

12 Well head completion: **12"**
 Pitless adapter Inches above grade

13 Well grouted? Yes No
 Neat cement Bentonite _____
Depth: From **0** ft. to **10** ft.

14 Nearest source of possible contamination: **in field**
ft. _____ Direction **none** Type _____
Well disinfected upon completion? Yes No

15 Pump: Not installed
Manufacturer's name **Goulds**
Model number **147** HP **150** Volts _____
Length of drop pipe **360** ft. capacity **1600** g.p.m.
Type:
 Submersible Turbine
 Jet Reciprocating
 Centrifugal Other

16 Remarks: elevation **Drilling Subcontracted to:
Minter-Wilson Drilling Co., License #208
Garden City, Kansas 67846**

Topography:
 Hill *** Lakewood Perf. - Slot - .125 X 66**
 Slope **Set between 180' & 370' and between**
 Upland **390' & 480'**
 Valley

17 Water well contractor's certification:
This well was drilled under my jurisdiction and this report is true to the best of my knowledge and belief.
K. I. Drilling Co. 263
Business name License No.
Address **Box 669, Ulysses, Kan.**
Signed **Bob Fuder** Date **2-26-75**
Authorized Representative