


1 LOCATION OF WATER WELL: County: Grant Fraction: NW 1/4 NW 1/4 NW 1/4 Section Number: 22 Township Number: T 29 S Range Number: R 38 E/W

Distance and direction from nearest town or city street address of well if located within city?
 From Ulysses - 5 Miles South, 5 Miles West, 4995 Ft. North and 5255 Ft. West

2 WATER WELL OWNER: Waldo Siebert
 RR#, St. Address, Box #: 5369 S. Road E Board of Agriculture, Division of Water Resources
 City, State, ZIP Code: Ulysses, Kansas 67880 Application Number: 422

3 LOCATE WELL'S LOCATION WITH AN "X" IN SECTION BOX:

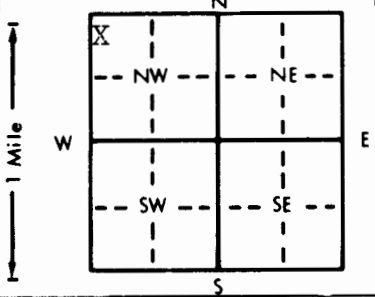

4 DEPTH OF COMPLETED WELL: 542 ft. ELEVATION: _____
 Depth(s) Groundwater Encountered 1. _____ ft. 2. _____ ft. 3. _____ ft.
 WELL'S STATIC WATER LEVEL: 219 ft. below land surface measured on mo/day/yr 4-20-92
 Pump test data: Well water was _____ ft. after _____ hours pumping _____ gpm
 Est. Yield _____ gpm: Well water was _____ ft. after _____ hours pumping _____ gpm
 Bore Hole Diameter: 30 in. to 542 ft., and _____ in. to _____ ft.
 WELL WATER TO BE USED AS: 5 Public water supply 8 Air conditioning 11 Injection well
 1 Domestic 3 Feedlot 6 Oil field water supply 9 Dewatering 12 Other (Specify below)
 Irrigation 4 Industrial 7 Lawn and garden only 10 Monitoring well
 Was a chemical/bacteriological sample submitted to Department? Yes _____ No ; If yes, mo/day/yr sample was submitted _____
 Water Well Disinfected? Yes _____ No

5 TYPE OF BLANK CASING USED:
 Steel 3 RMP (SR) 5 Wrought iron 8 Concrete tile CASING JOINTS: Glued _____ Clamped _____
 2 PVC 4 ABS 6 Asbestos-Cement 9 Other (specify below) Welded
 7 Fiberglass _____ Threaded _____
 Blank casing diameter: 16 in. to 527 ft., Dia. 20 in. to See Below, Dia. _____ in. to _____ ft.
 Casing height above land surface: 12 in., weight 16.42 lbs./ft. Wall thickness or gauge No. 250
20.52.73
 TYPE OF SCREEN OR PERFORATION MATERIAL:
 Steel 3 Stainless steel 5 Fiberglass 8 RMP (SR) 10 Asbestos-cement
 2 Brass 4 Galvanized steel 6 Concrete tile 9 ABS 11 Other (specify) _____
 12 None used (open hole)
 SCREEN OR PERFORATION OPENINGS ARE:
 1 Continuous slot 3 Mill slot 5 Gauzed wrapped 8 Saw cut 11 None (open hole)
 2 Louvered shutter 4 Key punched Wire wrapped 9 Drilled holes
 Torch cut 10 Other (specify) _____
 SCREEN-PERFORATED INTERVALS: 16" From 527 ft. to 542 ft., From _____ ft. to _____ ft.
20" From 237 ft. to 287 ft., From 342 ft. to 357 ft.
~~Gravel Pack Intervals~~ From 372 ft. to 392 ft., From 467 ft. to 527 ft.
 Gravel Pack Intervals From 85 ft. to 542 ft., From _____ ft. to _____ ft.

6 GROUT MATERIAL: 1 Neat cement Cement grout 3 Bentonite 4 Other _____
 Grout Intervals: From 0 ft. to 85 ft., From _____ ft. to _____ ft., From _____ ft. to _____ ft.
 What is the nearest source of possible contamination:
 1 Septic tank 4 Lateral lines 7 Pit privy 10 Livestock pens Abandoned water well
 2 Sewer lines 5 Cess pool 8 Sewage lagoon 11 Fuel storage 15 Oil well/Gas well
 3 Watertight sewer lines 6 Seepage pit 9 Feedyard 12 Fertilizer storage 16 Other (specify below)
 13 Insecticide storage _____
 Direction from well? Northeast How many feet? 185 ft. north & 75 ft. east

FROM	TO	LITHOLOGIC LOG	FROM	TO	PLUGGING INTERVALS
		See attached log			
		237' - 16" Plain Casing			
		50' - 16" Plain Casing X 20" Screen			
		55' - 16" Plain Casing X 20" Plain Casing			
		15' - 16" Plain Casing X 20" Screen			
		15' - 16" Plain Casing X 20" Plain Casing			
		20' - 16" Plain Casing X 20" Screen			
		75' - 16" Plain Casing X 20" Plain Casing			
		60' - 16" Plain Casing X 20" Screen			
		15' - Starter Section - 16" Torch Cut Perf. X 20" Plain Casing			

7 CONTRACTOR'S OR LANDOWNER'S CERTIFICATION: This water well was constructed, reconstructed, or plugged under my jurisdiction and was completed on (mo/day/year) 4-20-92 and this record is true to the best of my knowledge and belief. Kansas Water Well Contractor's License No. 208 This Water Well Record was completed on (mo/day/yr) 5-4-92 under the business name of Minter-Wilson Drilling Co., Inc. by (signature) Nora Keller