


1 LOCATION OF WATER WELL: Fraction NE 1/4 SW 1/4 SW 1/4 Section Number 28 Township Number T 29 S Range Number R 38 EW

Distance and direction from nearest town or city street address of well if located within city?
 From Ulysses: 5S and 6 1/2 W into--

2 WATER WELL OWNER: Webber Supply Grant County Feeders #8
 RR#, St. Address, Box # : 114 S Main Board of Agriculture, Division of Water Resources
 City, State, ZIP Code : Ulysses, KS 67880 Application Number: 39616

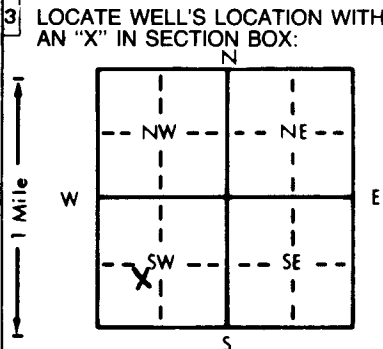

4 DEPTH OF COMPLETED WELL: 520 ft. ELEVATION:
 Depth(s) Groundwater Encountered 1. 220 ft. 2. ft. 3. ft.
 WELL'S STATIC WATER LEVEL: 220 ft. below land surface measured on mo/day/yr 11/29/91
 Pump test data: Well water was 240 ft. after 1 hours pumping 95 gpm
 Est. Yield 95 gpm: Well water was ft. after hours pumping gpm
 Bore Hole Diameter 11 in. to 520 ft., and in. to ft.
 WELL WATER TO BE USED AS:
 1 Domestic 3 Feedlot 5 Public water supply 8 Air conditioning 11 Injection well
 2 Irrigation 4 Industrial 6 Oil field water supply 9 Dewatering 12 Other (Specify below)
 7 Lawn and garden only 10 Monitoring well
 Was a chemical/bacteriological sample submitted to Department? Yes No X; If yes, mo/day/yr sample was submitted Water Well Disinfected? Yes X No

5 TYPE OF BLANK CASING USED:
 1 Steel 3 RMP (SR) 5 Wrought iron 8 Concrete tile CASING JOINTS: Glued X Clamped
 2 PVC 4 ABS 6 Asbestos-Cement 9 Other (specify below) Welded
 7 Fiberglass Threaded
 Blank casing diameter 6 in. to 520 ft., Dia in. to ft., Dia in. to ft.
 Casing height above land surface 24 in., weight lbs./ft. Wall thickness or gauge No. 032
 TYPE OF SCREEN OR PERFORATION MATERIAL:
 1 Steel 3 Stainless steel 5 Fiberglass 7 PVC 10 Asbestos-cement
 2 Brass 4 Galvanized steel 6 Concrete tile 8 RMP (SR) 11 Other (specify)
 9 ABS 12 None used (open hole)
 SCREEN OR PERFORATION OPENINGS ARE:
 1 Continuous slot 3 Mill slot 5 Gauzed wrapped 8 Saw cut 11 None (open hole)
 2 Louvered shutter 4 Key punched 6 Wire wrapped 9 Drilled holes
 7 Torch cut 10 Other (specify)
 SCREEN-PERFORATED INTERVALS: From 420 ft. to 520 ft., From ft. to ft.
 GRAVEL PACK INTERVALS: From 320 ft. to 520 ft., From ft. to ft.

6 GROUT MATERIAL: 1 Neat cement 2 Cement grout 3 Bentonite 4 Other Hole Plug
 Grout Intervals: From 1 ft. to 20 ft., From ft. to ft., From ft. to ft.
 What is the nearest source of possible contamination:
 1 Septic tank 4 Lateral lines 7 Pit privy 10 Livestock pens 14 Abandoned water well
 2 Sewer lines 5 Cess pool 8 Sewage lagoon 11 Fuel storage 15 Oil well/Gas well
 3 Watertight sewer lines 6 Seepage pit 9 Feedyard 12 Fertilizer storage 16 Other (specify below)
 13 Insecticide storage
 Direction from well? How many feet?

FROM	TO	LITHOLOGIC LOG	FROM	TO	PLUGGING INTERVALS
0	2	Surface Soil			
2	41	Sandy Clay			
41	84	Clay			
84	101	Sandy Clay			
101	132	Sand			
132	183	Sandy Clay and Clay			
183	194	Sand			
194	258	Sandy Clay and Clay			
258	275	Sand			
275	378	Sandy Clay and Clay			
378	452	Sand			
452	484	Sand and Gravel			
484	510	Sand			
510	520	Clay and Shale			

7 CONTRACTOR'S OR LANDOWNER'S CERTIFICATION: This water well was (1) constructed, (2) reconstructed, or (3) plugged under my jurisdiction and was completed on (mo/day/year) 11/29/91 and this record is true to the best of my knowledge and belief. Kansas Water Well Contractor's License No. KWCL-430 This Water Well Record was completed on (mo/day/yr) 11/29/91 under the business name of Howard Drilling Co. Box 806 Beaver, OK 73832

INSTRUCTIONS: Use typewriter or ball point pen. PLEASE PRESS FIRMLY and PRINT clearly. Please fill in blanks, underline or circle the correct answers. Send top three copies to Kansas Department of Health and Environment, Bureau of Water, Topeka, Kansas 66620-0001. Telephone: 913-296-5545. Send one to WATER WELL OWNER and retain one for your records.