


1 LOCATION OF WATER WELL: Fraction C 1/4 NE 1/4 NW 1/4 Section Number 28 Township Number T 29 S Range Number R 38 EW

Distance and direction from nearest town or city street address of well if located within city?  
 3 3/4 MILES SE OF GOGNAC, KS

2 WATER WELL OWNER: DOLOMITE RESOURCES #28-1 JANTZ  
 RR#, St. Address, Box #: 105S BROADWAY, Ste. 740 Board of Agriculture, Division of Water Resources  
 City, State, ZIP Code: WICHITA, KS 67202 Application Number: 930326

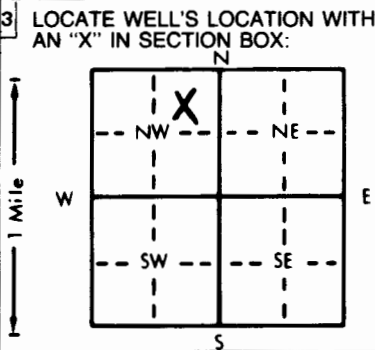

4 DEPTH OF COMPLETED WELL: 340 ft. ELEVATION: .....  
 Depth(s) Groundwater Encountered 1. 160 ft. 2. .... ft. 3. .... ft.  
 WELL'S STATIC WATER LEVEL: 160 ft. below land surface measured on mo/day/yr 8-27-93  
 Pump test data: Well water was 170 ft. after 1 hours pumping 100 gpm  
 Est. Yield 100 gpm: Well water was ..... ft. after ..... hours pumping ..... gpm  
 Bore Hole Diameter: 9 1/2 in. to 340 ft. and ..... in. to ..... ft.  
 WELL WATER TO BE USED AS:  
 5 Public water supply 8 Air conditioning 11 Injection well  
 1 Domestic 3 Feedlot 6 Oil field water supply 9 Dewatering 12 Other (Specify below)  
 2 Irrigation 4 Industrial 7 Lawn and garden only 10 Monitoring well  
 Was a chemical/bacteriological sample submitted to Department? Yes.....No.....X.....; If yes, mo/day/yr sample was submitted  
 Water Well Disinfected? Yes X No

5 TYPE OF BLANK CASING USED:  
 1 Steel 3 RMP (SR) 5 Wrought iron 8 Concrete tile CASING JOINTS: Glued X Clamped  
 2 PVC 4 ABS 6 Asbestos-Cement 9 Other (specify below) Welded  
 7 Fiberglass Threaded  
 Blank casing diameter 5 in. to 340 ft. Dia. in. to ..... ft. Dia. in. to ..... ft.  
 Casing height above land surface 24 in., weight 2.902 lbs./ft. Wall thickness or gauge No. 280 SDR 21  
 TYPE OF SCREEN OR PERFORATION MATERIAL:  
 1 Steel 3 Stainless steel 5 Fiberglass 8 RMP (SR) 10 Asbestos-cement  
 2 Brass 4 Galvanized steel 6 Concrete tile 9 ABS 11 Other (specify)  
 12 None used (open hole)  
 SCREEN OR PERFORATION OPENINGS ARE:  
 1 Continuous slot 3 Mill slot 5 Gauzed wrapped 8 Saw cut 11 None (open hole)  
 2 Louvered shutter 4 Key punched 6 Wire wrapped 9 Drilled holes  
 7 Torch cut 10 Other (specify)  
 SCREEN-PERFORATED INTERVALS: From 240 ft. to 340 ft. From ..... ft. to ..... ft.  
 GRAVEL PACK INTERVALS: From 280 ft. to 340 ft. From ..... ft. to ..... ft.

6 GROUT MATERIAL: 1 Neat cement 2 Cement grout 3 Bentonite 4 Other HOLE PLUG  
 Grout Intervals: From 1 ft. to 20 ft. From ..... ft. to ..... ft. From ..... ft. to ..... ft.  
 What is the nearest source of possible contamination:  
 1 Septic tank 4 Lateral lines 7 Pit privy 10 Livestock pens 14 Abandoned water well  
 2 Sewer lines 5 Cess pool 8 Sewage lagoon 11 Fuel storage 15 Oil well/Gas well  
 3 Watertight sewer lines 6 Seepage pit 9 Feedyard 12 Fertilizer storage 16 Other (specify below)  
 13 Insecticide storage  
 Direction from well? SOUTHEAST How many feet? 150

FROM	TO	LITHOLOGIC LOG	FROM	TO	PLUGGING INTERVALS
0	20	TOP SOIL & CLAY	300	320	MED. TO COARSE SAND 90/10
20	40	SANDY CLAY & FINE SAND	320	340	CLAY
40	60	SANDY CLAY & FINE TO COARSE SAND			
60	80	CLAY 90% & COARSE SAND 10%			
80	110	SANDY CLAY			
110	130	FINE TO COARSE SAND			
130	140	SANDY CLAY W/ MED. TO COARSE SAND			
140	160	FINE TO COARSE SAND			
160	195	FINE TO COARSE SAND W/ LITTLE SANDY CLAY			
195	200	CLAY WITH COARSE SAND			
200	220	CLAY & SANDSTONE			
220	240	CLAY & MED. TO COARSE SAND			
240	260	CLAY & FINE SAND			
260	280	SANDY CLAY WITH TO COARSE SAND			
280	300	COARSE SAND & CLAY 50/50			

7 CONTRACTOR'S OR LANDOWNER'S CERTIFICATION: This water well was (1) constructed, (2) reconstructed, or (3) plugged under my jurisdiction and was completed on (mo/day/year) 8-27-93 and this record is true to the best of my knowledge and belief. Kansas Water Well Contractor's License No. KWWCL-430 This Water Well Record was completed on (mo/day/yr) 8-27-93 under the business name of HOWARD DRLG. CO. BOX 806 BEAVER, OK 73932 by (signature)

INSTRUCTIONS: Use typewriter or ball point pen. PLEASE PRESS FIRMLY and PRINT clearly. Please fill in blanks, underline or circle the correct answers. Send top three copies to Kansas Department of Health and Environment, Bureau of Water, Topeka, Kansas 66620-0001. Telephone: 913-296-5545. Send one to WATER WELL OWNER and retain one for your records.