


1 LOCATION OF WATER WELL: Fraction Section Number Township Number Range Number
 County: Grant NE 1/4 SW 1/4 SW 1/4 28 T 29 S R 38 EW

Distance and direction from nearest town or city street address of well if located within city?
 From Ulysses: 5S, 4 1/2 W, 1/2 S, and W into--

2 WATER WELL OWNER: Webber Supply Grant County Feeders #3
 RR#, St. Address, Box #: 114 S Main Board of Agriculture, Division of Water Resources
 City, State, ZIP Code: Ulysses, KS 67:880 Application Number: 39619

3 LOCATE WELL'S LOCATION WITH AN "X" IN SECTION BOX:

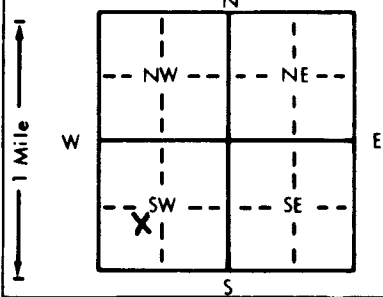

4 DEPTH OF COMPLETED WELL: 520 ft. ELEVATION:
 Depth(s) Groundwater Encountered 1. 280 ft. 2. ft. 3. ft.
 WELL'S STATIC WATER LEVEL: 280 ft. below land surface measured on mo/day/yr 10/16/91
 Pump test data: Well water was 331 ft. after 1 hours pumping 100 gpm
 Est. Yield 100 gpm: Well water was ft. after hours pumping gpm
 Bore Hole Diameter: 11 in. to 520 ft., and in. to ft.
 WELL WATER TO BE USED AS:
 5 Public water supply 8 Air conditioning 11 Injection well
 1 Domestic (3) Feedlot 6 Oil field water supply 9 Dewatering 12 Other (Specify below)
 2 Irrigation 4 Industrial 7 Lawn and garden only 10 Monitoring well
 Was a chemical/bacteriological sample submitted to Department? Yes.....No.....X.....; If yes, mo/day/yr sample was submitted
 Water Well Disinfected? Yes X No

5 TYPE OF BLANK CASING USED:
 1 Steel 3 RMP (SR) 5 Wrought iron 8 Concrete tile CASING JOINTS: Glued X Clamped
 (2) PVC 4 ABS 6 Asbestos-Cement 9 Other (specify below) Welded
 7 Fiberglass Threaded
 Blank casing diameter 6 in. to 520 ft., Dia. in. to ft., Dia. in. to ft.
 Casing height above land surface 24 in., weight lbs./ft. Wall thickness or gauge No. 032

TYPE OF SCREEN OR PERFORATION MATERIAL:
 1 Steel 3 Stainless steel 5 Fiberglass (7) PVC 10 Asbestos-cement
 2 Brass 4 Galvanized steel 6 Concrete tile 8 RMP (SR) 11 Other (specify)
 9 ABS 12 None used (open hole)
 SCREEN OR PERFORATION OPENINGS ARE:
 1 Continuous slot 3 Mill slot 5 Gauzed wrapped (8) Saw cut 11 None (open hole)
 2 Louvered shutter 4 Key punched 6 Wire wrapped 9 Drilled holes
 7 Torch cut 10 Other (specify)
 SCREEN-PERFORATED INTERVALS: From 414 ft. to 514 ft., From ft. to ft.
 From ft. to ft., From ft. to ft.
 GRAVEL PACK INTERVALS: From 280 ft. to 520 ft., From ft. to ft.
 From ft. to ft., From ft. to ft.

6 GROUT MATERIAL: (1) Neat cement 2 Cement grout 3 Bentonite (4) Other Hole Plug
 Grout Intervals: From 1 ft. to 20 ft., From ft. to ft., From ft. to ft.
 What is the nearest source of possible contamination:
 1 Septic tank 4 Lateral lines 7 Pit privy 10 Livestock pens 14 Abandoned water well
 2 Sewer lines 5 Cess pool 8 Sewage lagoon 11 Fuel storage 15 Oil well/Gas well
 3 Watertight sewer lines 6 Seepage pit 9 Feedyard 12 Fertilizer storage 16 Other (specify below)
 13 Insecticide storage
 Direction from well? How many feet?

FROM	TO	LITHOLOGIC LOG	FROM	TO	PLUGGING INTERVALS
0	1	Surface Soil	376	438	Sand
1	50	Clay	438	518	Sand and Gravel
50	60	Sand	518	520	Clay
60	74	Sandy Clay			
74	102	Clay			
102	134	Sand			
134	186	Sandy Clay			
186	238	Clay and streaks of Sand			
238	263	Clay			
263	284	Sand			
284	295	Clay			
295	314	Sand			
314	327	Clay			
327	354	Sand			
354	376	Clay			

7 CONTRACTOR'S OR LANDOWNER'S CERTIFICATION: This water well was (1) constructed, (2) reconstructed, or (3) plugged under my jurisdiction and was completed on (mo/day/year) 10/16/91 and this record is true to the best of my knowledge and belief. Kansas Water Well Contractor's License No. KWWCL-430 This Water Well Record was completed on (mo/day/yr) 10/16/91 under the business name of Howard Drilling Co. Box 806 Beaver, OK 73962 (signature)

INSTRUCTIONS: Use typewriter or ball point pen. PLEASE PRESS FIRMLY and PRINT clearly. Please fill in blanks, underline or circle the correct answers. Send top three copies to Kansas Department of Health and Environment, Bureau of Water, Topeka, Kansas 66620-0001. Telephone: 913-296-5545. Send one to WATER WELL OWNER and retain one for your records.