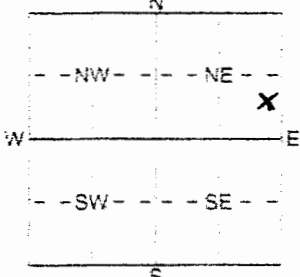


1. LOCATION OF WATER WELL: Fraction NE 1/4 SE 1/4 NE 1/4 Section Number 12 Township Number T 29 S Range Number R 38 E/W
 County: Grant

Distance and direction from nearest town or city street address of well if located within city?
2 South 2.5 West of Ulysses

2. WATER WELL OWNER: Jason Hauser
 RR#, St. Address, Box #: _____
 City, State, ZIP Code: Ulysses Ks 67880 Board of Agriculture, Division of Water Resources Application Number: _____

3. LOCATE WELL'S LOCATION WITH: 4. DEPTH OF COMPLETED WELL 455 ft. ELEVATION: _____
 AN "X" IN SECTION BOX:

 Depth(s) Groundwater Encountered: 1 205 ft. 2 _____ ft. 3 _____ ft.
 WELL'S STATIC WATER LEVEL 205 ft. below land surface measured on (mo/day/yr) 8/23/06
 Pump test data: Well water was _____ ft. after _____ hours pumping _____ gpm
 Est. Yield _____ gpm: Well water was _____ ft. after _____ hours pumping _____ gpm
 WELL WATER TO BE USED AS:
 1 Domestic 3 Feedlot 6 Off field water supply 9 Dewatering 12 Other (Specify below)
 2 Irrigation 4 Industrial 7 Domestic (lawn & garden) 10 Monitoring well
 Was a chemical/bacteriological sample submitted to Department? Yes _____ No If yes, (mo/day/yr) sample was submitted _____
 Water Well Disinfected? Yes No _____

5. TYPE OF BLANK CASING USED:
 1 Steel 3 RMP (SR) 5 Wrought iron 8 Concrete tile CASING JOINTS: Glued _____ Clampac _____
 2 PVC 4 ABS 6 Asbestos-Cement 9 Other (specify below) _____ Welded _____
 7 Fiberglass _____ E 2912-LOC Threaded _____
 Blank casing diameter 5 in. to 455 ft. Dia _____ in. to _____ ft. Dia _____ in. to _____ ft. Dia _____ in. to _____ ft. Dia _____
 Casing height above land surface 24 in. weight _____ lbs./ft. Wall thickness or gauge No. SDR 21x17
 TYPE OF SCREEN OR PERFORATION MATERIAL:
 1 Steel 3 Stainless Steel 5 Fiberglass 7 PVC 10 Asbestos-Cement
 2 Brass 4 Galvanized Steel 6 Concrete tile 8 RMP (SR) 11 Other (Specify) _____
 12 None used (open hole)
 SCREEN OR PERFORATION OPENINGS ARE:
 1 Continuous slot 3 Mill slot 5 Gauzed wrapped 8 Saw cut 11 None (open hole)
 2 Louvered shutter 4 Key punched 6 Wire wrapped 9 Drilled holes
 7 Toron cut 10 Other (specify) _____ ft.
 SCREEN-PERFORATED INTERVALS: From 295 ft. to 315 ft. From 335 ft. to 355 ft.
 From 375 ft. to 395 ft. From 415 ft. to 435 ft.
 GRAVEL PACK INTERVALS: From 25 ft. to 455 ft. From _____ ft. to _____ ft.
 From _____ ft. to _____ ft. From _____ ft. to _____ ft.

6. GROUT MATERIAL: 1 Neat cement 2 Cement grout 3 Bentonite 4 Other _____
 Grout intervals: From 5 ft. to 35 ft. From _____ ft. to _____ ft. From _____ ft. to _____ ft.
 What is the nearest source of possible contamination:
 1 Septic tank 4 Lateral lines 7 Pit privy 10 Livestock pens 14 Abandoned water well
 2 Sewer lines 5 Cess pool 8 Sewage lagoon 11 Fuel storage 15 Oil well/Gas well
 3 Watertight sewer lines 6 Seepage pit 9 Feedyard 12 Fertilizer storage 16 Other (specify below) _____
 13 Insecticide storage None observed
 Direction from well? _____ How many feet? _____

FROM	TO	LITHOLOGIC LOG	FROM	TO	PLUGGING INTERVALS
0	10	Top soil & clay			
10	20	med sand			
20	140	Sandy clay			
140	180	Fine sand & a little clay			
180	200	Fine to med sand			
200	235	Sandy clay			
235	260	med sand			
260	300	Sandy clay			
300	352	med sand			
352	369	clay			
369	380	med sand			
380	414	Blue clay			
414	455	Sandstone			

7. CONTRACTOR'S OR LANDOWNER'S CERTIFICATION: This water well was (1) constructed, (2) reconstructed, or (3) plugged under my jurisdiction and was completed on (mo/day/year) 8-22-06 and this record is true to the best of my knowledge and belief, Kansas Water Well Contractor's Licence No. 473 This Water Well Record was completed on (mo/day/yr) 8/29/06 under the business name of Tyler Water Well Inc. by (signature) Paul Ely