

WATER WELL PLUGGING RECORD Form WWC-5P KSA 82a-1212 ID NO.


1 LOCATION OF WATER WELL: County: Grant	Fraction ¼ SW ¼ NE ¼ NE ¼	Section Number 5	Township Number T 29 S	Range Number 38 <input type="checkbox"/> E <input checked="" type="checkbox"/> W
---	------------------------------	---------------------	---------------------------	---

Street Rural Address of Well Location: if unknown, distance & direction from nearest town or intersection: If at owner's address, check here Hwy 160 & 25 7 miles west on hwy 160

1 miles south 874' south of north line 888' west

Global Positioning Systems (GPS) information:
 Latitude: _____ (in decimal degrees)
 Longitude: _____ (in decimal degrees)
 Elevation: _____
 Datum: WGS84. NAD83. NAD27
Collection Method:
 GPS unit (Make Model: _____)
 Digital Map Photo. Topographic Map. Land Survey
 Est. Accuracy: 3 m. 3-5 m. 5-15 m. 15 m

2 WATER WELL OWNER: BP America Production Co.
 RR#, St. Address, Box #: 2225 W. Oklahoma Ave.
 City, State ZIP Code: Ulysses KS 67880

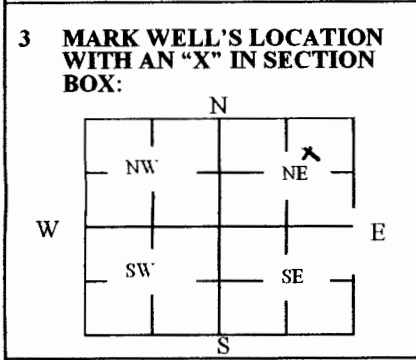

4 DEPTH OF WELL 453 ft.
WELL'S STATIC WATER LEVE 225 ft.
WELL WAS USED AS:
 Domestic Public Water Supply Dewatering
 Irrigation Oil Field Water Supply Monitoring
 Feedlot Domestic (Lawn & Garden) Injection Well
 Industrial Air Conditioning Other _____
 Was a chemical/bacteriological sample submitted to Department? Yes No

5 TYPE OF BLANK CASING USED:
 Steel RMP (SR) Wrought Fiberglass Other (Specify below) _____
 PVC ABS Asbestos-Cement Concrete Tile
 Blank casing diameter ¹⁴ in. Was casing pulled? Yes No If yes, how much _____
 Casing height above or below land surface 72 in.

6 GROUT PLUG MATERIAL: Neat cement Cement grout Bentonite Other _____
 Grout Plug Intervals: From 6 ft. to 60 ft., From 220 ft. to 225 ft., From _____ to _____ ft.
What is the nearest source of possible contamination:
 Septic tank Seepage pit Fuel Storage Other (specify below) _____
 Sewer lines Pit privy Fertilizer storage in plant well
 Watertight sewer lines Sewage lagoon Insecticide storage
 Lateral lines Feedyard Abandoned water well Direction from well? _____
 Cess pool Livestock pens Oil well/Gas well How many feet? _____

FROM	TO	PLUGGING MATERIALS	FROM	TO	PLUGGING MATERIALS
0	6	Top soil			
6	60	Cement Grout			
60	220	Chlorinated Gravel			
220	225	Bentonite Grout			
225	453	Chlorinated Gravel			

7 CONTRACTOR'S OR LANDOWNER'S CERTIFICATION: This water well was plugged under my jurisdiction and was completed on (mo/day/year) 5/13/09 and this record is true to the best of my knowledge and belief. Kansas Water Well Contractor's License No. 775. This Water Well Record was completed on (mo/day/year) 5/14/09 under the business name of Martin's Well Service by (signature) *Kenny Martin*

INSTRUCTIONS: Use typewriter or ballpoint pen. Please press firmly and print clearly. Please fill in blanks, underline or circle the correct answers. Send top three copies to Kansas Department of Health and Environment, Bureau of Water, Geology Section, 1000 SW Jackson St., Ste. 420, Topeka, Kansas 66612-1367. Telephone: 785/296-5524. Send one to Water Well Owner and retain one for your records. Visit us at <http://www.kdheks.gov/waterwell/index.html>.

Check one: White Copy Blue Copy Pink Copy