

WATER WELL PLUGGING RECORD Form WWC-5P

KSA 82a-1212

ID NO.


29,258

1 LOCATION OF WATER WELL: County: GRANT	Fraction ¼ SE ¼ NE ¼ SE ¼	Section Number 29	Township Number T 29 S	Range Number 38 <input type="checkbox"/> E <input checked="" type="checkbox"/> W
---	------------------------------	----------------------	---------------------------	---

Street/Rural Address of Well Location; if unknown, distance & direction from nearest town or intersection: If at owner's address, check here SOUTH SIDE OF ULYSSES-6 M S,
7 M W, 1,970 FT. N. & 50 FT. W.

2 WATER WELL OWNER: FIVE RIVERS RANCH
RR#, St. Address, Box #: CATTLE FEEDING, LLC.
City, State ZIP Code: PO BOX 1087
ULYSSES, KS 67880

Global Positioning Systems (GPS) information:
Latitude: _____ (in decimal degrees)
Longitude: _____ (in decimal degrees)
Elevation: _____
Datum: WGS84, NAD83, NAD27
Collection Method:
 GPS unit (Make/Model: _____)
 Digital Map/Photo, Topographic Map, Land Survey
Est. Accuracy: < 3 m, 3-5 m, 5-15 m, > 15 m

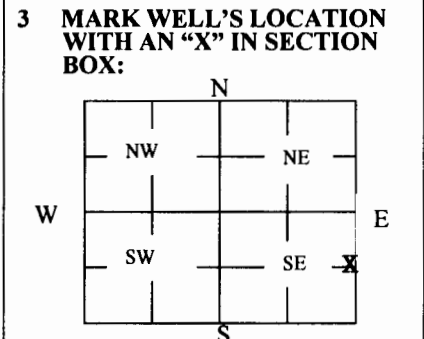

4 DEPTH OF WELL 480 ft.
WELL'S STATIC WATER LEVEL 320 ft.
WELL WAS USED AS:
 Domestic Public Water Supply Dewatering
 Irrigation Oil Field Water Supply Monitoring
 Feedlot Domestic (Lawn & Garden) Injection Well
 Industrial Air Conditioning Other _____
Was a chemical/bacteriological sample submitted to Department? Yes No

5 TYPE OF BLANK CASING USED:
 Steel RMP (SR) Wrought Fiberglass Other (Specify below)
 PVC ABS Asbestos-Cement Concrete Tile _____
Blank casing diameter 16 in. Was casing pulled? Yes No If yes, how much 3 FT.
Casing height above or below land surface 36 in. **BELOW**

6 GROUT PLUG MATERIAL: Neat cement Cement grout Bentonite Other _____
Grout Plug Intervals: From 3 ft. to 320 ft., From _____ ft. to _____ ft., From _____ to _____ ft.
What is the nearest source of possible contamination:
 Septic tank Seepage pit Fuel Storage Other (specify below)
 Sewer lines Pit privy Fertilizer storage N/A
 Watertight sewer lines Sewage lagoon Insecticide storage _____
 Lateral lines Feedyard Abandoned water well Direction from well? _____
 Cess pool Livestock pens Oil well/Gas well How many feet? _____

FROM	TO	PLUGGING MATERIALS	FROM	TO	PLUGGING MATERIALS
0'	3'	TOP SOIL			
3'	320'	CEMENT GROUT			
320'	480'	CHLORINATED GRAVEL			

7 CONTRACTOR'S OR LANDOWNER'S CERTIFICATION: This water well was plugged under my jurisdiction and was completed on (mo/day/year) 10-2-12 and this record is true to the best of my knowledge and belief. Kansas Water Well Contractor's License No. 208. This Water Well Record was completed on (mo/day/year) 10-3-12 under the business name of MINTER-WILSON DRILLING CO., INC. by (signature) Nora Keller

INSTRUCTIONS: Use typewriter or ballpoint pen. Please press firmly and print clearly. Please fill in blanks, underline or circle the correct answers. Send top three copies to Kansas Department of Health and Environment, Bureau of Water, Geology Section, 1000 SW Jackson St., Ste. 420, Topeka, Kansas 66612-1367. Telephone: 785/296-5524. Send one to Water Well Owner and retain one for your records. Visit us at <http://www.kdheks.gov/waterwell/index.html>.

Check one: White Copy Blue Copy Pink Copy