



WATER WELL RECORD Form WWC-5 1085952

Division of Water Resources App. No. []

Well ID []

Original Record Correction Change in Well Use

1 LOCATION OF WATER WELL:
County: _____

Fraction
1/4 1/4 1/4 1/4


Section Number

Township Number
T S

Range Number
R E W

2 WELL OWNER: Last Name: _____
Business: _____
Address: _____
Address: _____
City: _____ State: _____ ZIP: _____

Street or Rural Address where well is located (if unknown, distance and direction from nearest town or intersection): If at owner's address, check here:

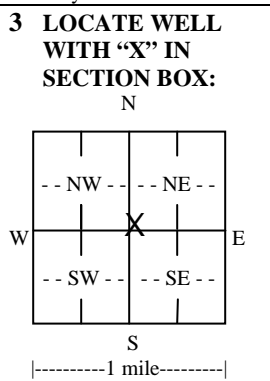

4 DEPTH OF COMPLETED WELL: ft.
Depth(s) Groundwater Encountered: 1) ft.
2) ft. 3) ft., or 4) Dry Well
WELL'S STATIC WATER LEVEL: ft.
 below land surface, measured on (mo-day-yr).....
 above land surface, measured on (mo-day-yr).....
Pump test data: Well water was ft.
after..... hours pumping gpm
Well water was ft.
after..... hours pumping gpm
Estimated Yield:gpm
Bore Hole Diameter: in. to ft. and
..... in. to ft.

5 Latitude:(decimal degrees)
Longitude:(decimal degrees)
Datum: WGS 84 NAD 83 NAD 27
Source for Latitude/Longitude:
 GPS (unit make/model:)
(WAAS enabled? Yes No)
 Land Survey Topographic Map
 Online Mapper:

6 Elevation:ft. Ground Level TOC
Source: Land Survey GPS Topographic Map
 Other

- 7 WELL WATER TO BE USED AS:**
- 1. Domestic: Household Lawn & Garden Livestock
 - 2. Irrigation
 - 3. Feedlot
 - 4. Industrial
 - 5. Public Water Supply: well ID
 - 6. Dewatering: how many wells?
 - 7. Aquifer Recharge: well ID
 - 8. Monitoring: well ID
 - 9. Environmental Remediation: well ID
 Air Sparge Soil Vapor Extraction
 Recovery Injection

- 10. Oil Field Water Supply: lease
- 11. Test Hole: well ID
 Cased Uncased Geotechnical
- 12. Geothermal: how many bores?
a) Closed Loop Horizontal Vertical
b) Open Loop Surface Discharge Inj. of Water
- 13. Other (specify):

Was a chemical/bacteriological sample submitted to KDHE? Yes No If yes, date sample was submitted:
Water well disinfected? Yes No

8 TYPE OF CASING USED: Steel PVC Other **CASING JOINTS:** Glued Clamped Welded Threaded
Casing diameter in. to ft., Diameter in. to ft., Diameter in. to ft.
Casing height above land surface in. Weight lbs./ft. Wall thickness or gauge No.
TYPE OF SCREEN OR PERFORATION MATERIAL:
 Steel Stainless Steel Fiberglass PVC Other (Specify)
 Brass Galvanized Steel Concrete tile None used (open hole)
SCREEN OR PERFORATION OPENINGS ARE:
 Continuous Slot Mill Slot Gauze Wrapped Torch Cut Drilled Holes Other (Specify)
 Louvered Shutter Key Punched Wire Wrapped Saw Cut None (Open Hole)
SCREEN-PERFORATED INTERVALS: From ft. to ft., From ft. to ft., From ft. to ft.
GRAVEL PACK INTERVALS: From ft. to ft., From ft. to ft., From ft. to ft.

9 GROUT MATERIAL: Neat cement Cement grout Bentonite Other
Grout Intervals: From ft. to ft., From ft. to ft., From ft. to ft.

Nearest source of possible contamination:
 Septic Tank Lateral Lines Pit Privy Livestock Pens Insecticide Storage
 Sewer Lines Cess Pool Sewage Lagoon Fuel Storage Abandoned Water Well
 Watertight Sewer Lines Seepage Pit Feedyard Fertilizer Storage Oil Well/Gas Well
 Other (Specify)
Direction from well? Distance from well? ft.

10 FROM	TO	LITHOLOGIC LOG	FROM	TO	LITHO. LOG (cont.) or PLUGGING INTERVALS

Notes:

11 CONTRACTOR'S OR LANDOWNER'S CERTIFICATION: This water well was constructed, reconstructed, or plugged under my jurisdiction and was completed on (mo-day-year) and this record is true to the best of my knowledge and belief. Kansas Water Well Contractor's License No. This Water Well Record was completed on (mo-day-year) under the business name of

Send one copy to WATER WELL OWNER and retain one for your records. Fee of \$5.00 for each constructed well.

Form	WWC5
Contractor	Hydro Resources Mid Continent, Inc.
Well Owner	
Doc ID	1085952

Litholgy

From	To	LithologicLog
0	2	SURFACE
2	92	BROWN CLAY, CALICHE
92	98	SAND FINE TO MED
98	105	BROWN CLAY
105	119	SAND MED FEW CLAY
119	134	BROWN CLAY
134	289	SAND FINE TO MED COARSE FEW CLAY
289	300	BROWN CLAY, LIMEROCK
300	308	SAND MED, FEW CEMENT
308	334	BROWN CLAY, FEW SAND
334	400	SAND MED FEW CLAY
400	444	SAND MED COARSE
444	456	SANDSTONE
456	485	SOAPSTONE
485	536	SOAPSTONE, SANDSTONE
536	590	SOAPSTONE , FEW SANDSTONE
590	600	RED BED