

NE 2-29-39

26,064

WATER WELL RECORD


Form WWC-5

Division of Water Resources App. No.

1 LOCATION OF WATER WELL: County: STANTON Fraction 1/4 1/4 NE 1/4 NE 1/4 Section Number 2 Township No. T 29 S Range Number R 39 [] E [X] W

Street/Rural Address of Well Location; if unknown, distance & direction from nearest town or intersection: If at owner's address, check here []. 11 MILES EAST & 1 1/8 MILES SOUTH OF JOHNSON, KANSAS Global Positioning System (GPS) information: Latitude: Longitude: Elevation: Datum: [] WGS 84, [] NAD 83, [] NAD 27 Collection Method: [] GPS unit (Make/Model: [] Digital Map/Photo, [] Topographic Map, [] Land Survey Est. Accuracy: [] <3 m, [] 3-5 m, [] 5-15 m, [] >15 m

2 WATER WELL OWNER: DOUGLAS F BELL RR#, Street Address, Box #: 1 FORD DRIVE City, State, ZIP Code : COLBY KS 67701

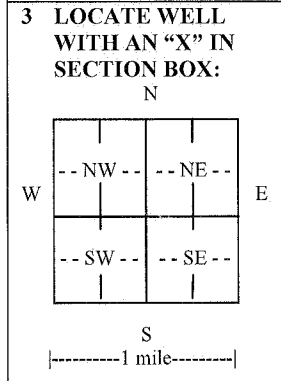

3 LOCATE WELL WITH AN 'X' IN SECTION BOX: N W E S 1 mile 4 DEPTH OF COMPLETED WELL 470 Depth(s) Groundwater Encountered (1) 362 (2) (3) WELL'S STATIC WATER LEVEL 362 ft. below land surface measured on mo/day/yr. Pump test data: Well water was ...ft. after ... hours pumping ... gpm EST. YIELD ... gpm. Well water was ...ft. after ... hours pumping ... gpm Bore Hole Diameter ...in. to ...ft., and ...in. to ...ft. WELL WATER TO BE USED AS: [] Public water supply [] Geothermal [] Injection well [] Domestic [] Feedlot [] Oil field water supply [] Dewatering [] Other (Specify below) [X] Irrigation [] Industrial [] Domestic-lawn & garden [] Monitoring well Was a chemical/bacteriological sample submitted to Department? [] Yes [] No If yes, mo/day/yr sample was submitted. Water well disinfected? [] Yes [] No

5 TYPE OF CASING USED: [X] Steel [] PVC [] Other CASING JOINTS: [] Glued [] Clamped [X] Welded [] Threaded Casing diameter .16 in. to ... ft., Diameter ... in. to ... ft., Diameter ... in. to ... ft. Casing height above land surface ... in., Weight ... lbs./ft., Wall thickness or gauge No. TYPE OF SCREEN OR PERFORATION MATERIAL: [X] Steel [] Stainless Steel [] PVC [] Brass [] Galvanized Steel [] None used (open hole) SCREEN OR PERFORATION OPENINGS ARE: [] Continuous slot [] Mill slot [] Gauze wrapped [] Torch cut [] Drilled holes [] None (open hole) [] Louvered shutter [] Key punched [X] Wire wrapped [] Saw cut [] Other (specify) SCREEN-PERFORATED INTERVALS: From ... ft. to ... ft., From ... ft. to ... ft., From ... ft. to ... ft. GRAVEL PACK INTERVALS: From ... ft. to ... ft., From ... ft. to ... ft., From ... ft. to ... ft.

6 GROUT MATERIAL: [] Neat cement [X] Cement grout [X] Bentonite [] Other Grout Intervals: From ... ft. to ... ft., From ... ft. to ... ft., From ... ft. to ... ft. What is the nearest source of possible contamination: [] Septic tank [] Lateral lines [] Pit privy [] Livestock pens [] Insecticide storage [] Other (specify below) [] Sewer lines [X] Cesspool [] Sewage lagoon [] Fuel storage [] Abandoned water well [] Watertight sewer lines [] Seepage pit [] Feedyard [] Fertilizer storage [] Oil well/gas well Direction from well SOUTHWEST Distance from well .5000 FT.

Table with columns: FROM, TO, LITHOLOGIC LOG, FROM, TO, LITHO. LOG (cont.) or PLUGGING INTERVALS. Row 1: 470, 6, WASHED SAND (CHLORINATED), Row 2: 6, 3, BENTONITE, Row 3: 3, 0, TOP SOIL

7 CONTRACTOR'S OR LANDOWNER'S CERTIFICATION: This water well was [] constructed, [] reconstructed, or [X] plugged under my jurisdiction and was completed on (mo/day/year) 12-16-2013. ... and this record is true to the best of my knowledge and belief. Kansas Water Well Contractor's License No. 722. This Water Well Record was completed on (mo/day/year) 01-24-2014 under the business name of WESTERN SPRINKLERS, INC. by (signature) [Signature]

INSTRUCTIONS: Use typewriter or ball point pen. PLEASE PRESS FIRMLY and PRINT clearly. Please fill in blanks and check the correct answers. Send one copy to Kansas Department of Health and Environment, Bureau of Water, Geology Section, 1000 SW Jackson St., Suite 420, Topeka, Kansas 66612-1367. Telephone 785-296-5524. Send one copy to WATER WELL OWNER and retain one for your records. Include fee of \$5.00 for each constructed well. Visit us at http://www.kdheks.gov/waterwell/index.html